

OFFICE OF THE
DOUGLAS COUNTY SURVEYOR

Station: T 496


T 25 S, R 2W , Sec 30

Date Set: 1942

Set By (Agency): USC+GS


Date Recovered: 3-1-00

Recovered By: RWS SJF

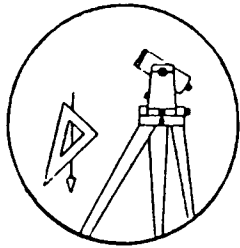

T-011

- Found
- New
- Reset
- Not Found
- Referenced
- Destroyed

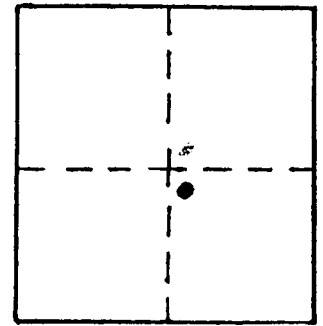

VERTICAL CONTROL

Elevation: 465.367 NGS Line # 98 USGS Line # _____ OSHD Line # _____

Precision: 2nd Agency: USC+GS Proj. # _____ Date: 1956

HORIZONTAL CONTROL CORPSCON6 NAVD88 468.87 FT. CS 66/53

South Zone O.C.S. 27: Y(Northing) _____ X(Easting) _____

South Zone O.C.S. 83: Y(Northing) 634674 X(Easting) 4104008

Precision: GIS SCALED Agency: DCSO Proj. # _____ Date: 2014

Approx. NAD ⁸³ Geographic Position: Latitude 43 22 01 Longitude 123 34 22

DESCRIPTION and TO REACH

USC+GS DISK STAMPED "T 496 1942" SET IN
CONCRETE POST 7" BELOW GROUND

FROM THE INTERSECTION OF MELQUA RD (CORD #13A)
AND HUBBARD CRK RD (CORD #6) PROCEED WESTERLY
ALONG HUBBARD CRK RD 5.8 MILES TO MONUMENT
ON LEFT.

Reference Marks:

HUBBARD CRK
RD

PHONE BOX
231
WEST 5'

WIT POST
+ SIGN
S 45° W
15'

PRIVATE RD
7440

