


OFFICE OF THE
DOUGLAS COUNTY SURVEYOR

T-017

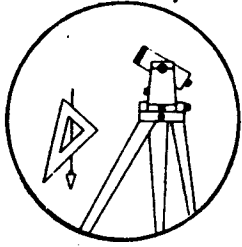

Station: T-609 T 32 S, R 6 W, Sec 35

Set By (Agency): OSHD

Date Set: 1966

Recovered By LEM


Date Recovered 2/82

Recovered By _____

Date Recovered _____

Recovered By _____

Date Recovered _____

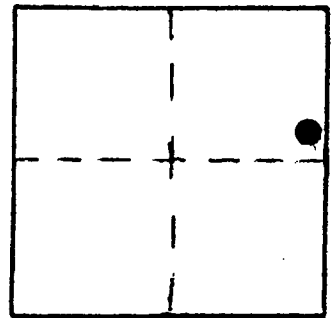

VERTICAL CONTROL CORPSCON6 NAVD88 1567.90 FT.

Elevation: 1564.52 NGS Line # _____ USGS Line # _____ OSHD Line # 310E (369)

Precision: 3rd Agency: OSHD Proj. # _____ Date: 1966

HORIZONTAL CONTROL

South Zone State Plane Coordinates: Y(Northing) 406236 X(Easting) 4150155

Precision: G/S SCALED Agency: DCSO Proj. # _____ Date: 2014



Approximate Geographic Position: Latitude _____ Longitude _____

DESCRIPTION and TO REACH

SKETCH

Station mark is a standard OSHD cap stamped "T-609 11-66". It is set flush on curb of overpass, 0.7 ft. above bridge deck and 0.3 ft. from edge of curb.

To Reach: This station is located at the Glendale interchange overpass (I-5 exit #80). Said station is at the Southerly end of the Westerly side of the overpass over the north-bound lanes of I-5.

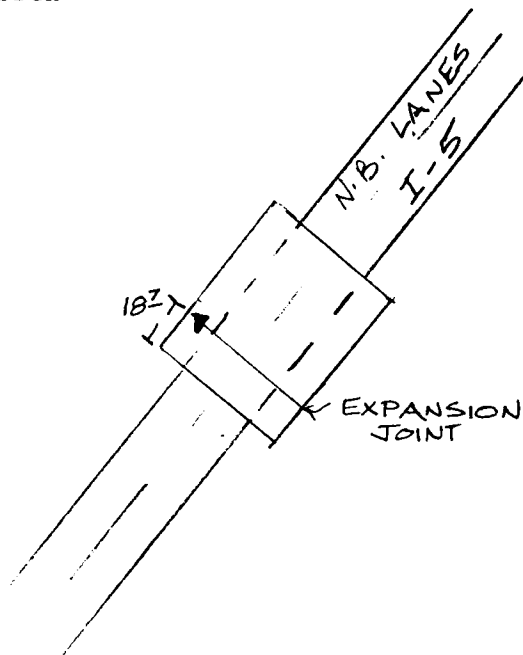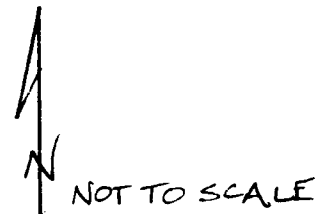

Reference Marks:

Note: For further information, contact the Douglas County Surveyor's Office, Room 205 Douglas County Justice Building, Roseburg, OR 97470. Phone 440-4278. Douglas County residents outside the Roseburg calling area, dial toll free 1-800-452-0991.