

OFFICE OF THE
DOUGLAS COUNTY SURVEYOR

Station: TAVENNER

T 29 S, R 4W , Sec 5

Date Set: 1991

Set By (Agency): DCSO

Date Recovered: 3/8/91



Recovered By: SJF - TF

Date Recovered: _____

Recovered By: _____

Date Recovered: _____

Recovered By: _____

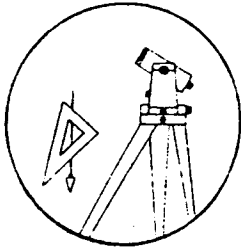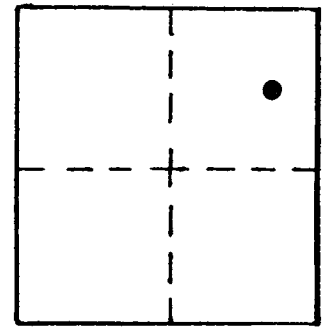

DESIG. T-074

VERTICAL CONTROL

Elevation: 850.298 NGS Line # _____ USGS Line # _____ OSHD Line # _____

Precision: 2nd Agency: DCSO Proj. # 2007 Date: 1991

HORIZONTAL CONTROL CORPSCONG NAVD88 853.738 FT. CS 66/43

South Zone O.C.S. 27: Y(Northing) _____ X(Easting) _____

South Zone O.C.S. 83: Y(Northing) 526823 X(Easting) 4202773

Precision: GIS SCALED Agency: DCSO Proj. # _____ Date: 2014

Approx. NAD 83 Geographic Position: Latitude 43°04'50" Longitude 123°11'21"

DESCRIPTION and TO REACH

A standard DCSO disk stamped "TAVENNER 1991" set in a 8" x 40" concrete filled belltile protruding 6" above ground.


To reach:

From the intersection of North Myrtle Rd. (Co. Rd. #15) and Frozen Creek Rd. (Co Rd. #104) in T29S, R4W, sec. 5 proceed northeasterly along North Myrtle Rd. 0.35 mi. to mon. on the left.

SKETCH

4202773.530

526823.312

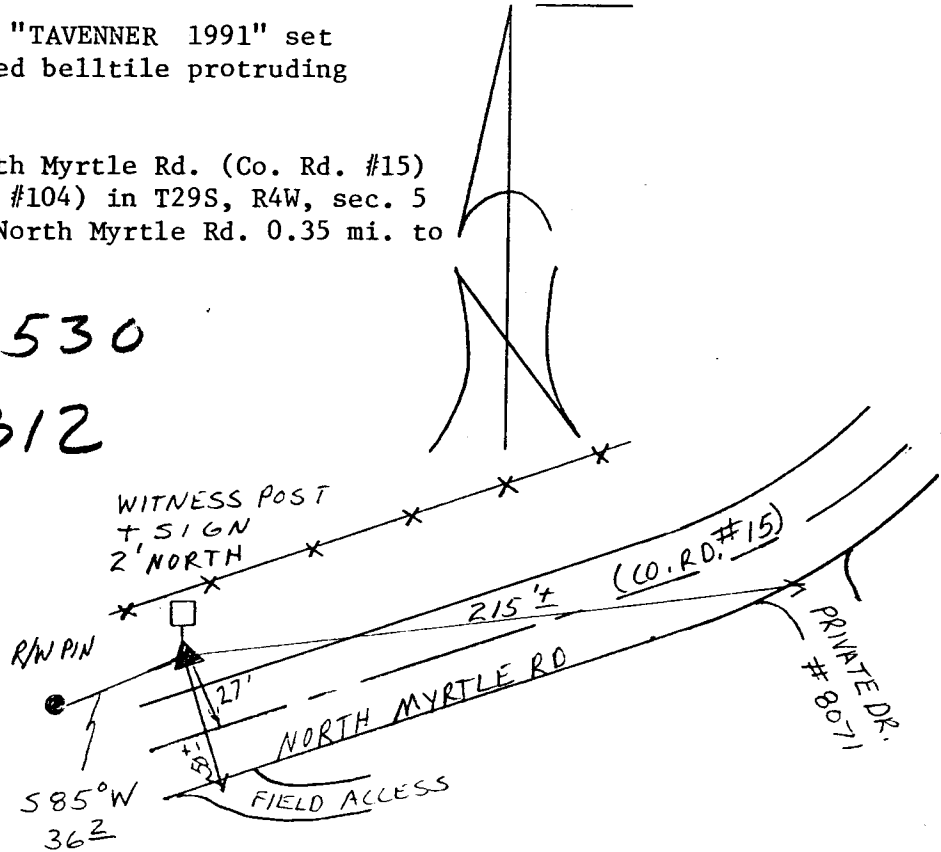

Reference Marks:

Note: For further information, contact the Douglas County Surveyor's Office, Room 205 Douglas County Justice Building, Roseburg, OR 97470. Phone 440-4278. Douglas County residents outside the Roseburg calling area, dial toll free 1-800-452-0991.