

OFFICE OF THE  
DOUGLAS COUNTY SURVEYOR

Station: TBM 8.25


T 22 S, R 9 , Sec 31

Date Set: 1988


Set By (Agency): \_\_\_\_\_

Date Recovered: 2-11-97

Recovered By: RWS SJF

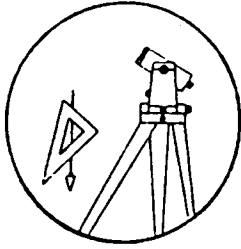

- Found
- Reset
- Referenced
- New
- Not Found
- Destroyed

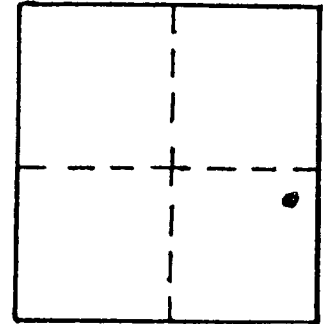

VERTICAL CONTROL

CORPCON 6 NAVD 88 417.40 FT

Elevation: 413.76 FT NGS Line # \_\_\_\_\_ USGS Line # \_\_\_\_\_ OSHD Line # \_\_\_\_\_

Precision: 3rd Agency: DCSO Proj. # 2007 Date: 1997

HORIZONTAL CONTROL

CS66/54

South Zone O.C.S. 27: Y(Northing) \_\_\_\_\_ X(Easting) \_\_\_\_\_

South Zone O.C.S. 83: Y(Northing) 720359 X(Easting) 4203761

Precision: GIS SCALED Agency: DCSO Proj. # \_\_\_\_\_ Date: 2014

Approx. 1927 Geographic Position: Latitude 43°36'41" Longitude 123°12'30"

DESCRIPTION and TO REACH

3/4" BOLT THROUGH A 1 3/4" METAL WASHER WITH  
STAMP MARK "104" WE STAMP "TBM 8.25"  
SET IN NORTH EAST CORNER OF BRIDGE CURB

FROM THE INTERSECTION OF CO. RD #8,  
(SCOTT'S VALLEY RD) AND ELKHORN ROAD (CO. RD #7)  
IN T22 S R9 W SEC. 31 PROCEED NORTHEAST ALONG  
SCOTT'S VALLEY RD 0.75 MILES TO MONUMENT  
ON LEFT IN NORTHEAST CORNER OF BRIDGE CURB.

Reference Marks:

