

OFFICE OF THE
DOUGLAS COUNTY SURVEYOR

Station: TRI 900


T 26 S, R 4 W, Sec 19

Date Set: 1999

Set By (Agency): DCSO


Date Recovered: 5-20-1999

Recovered By: RWS SJF

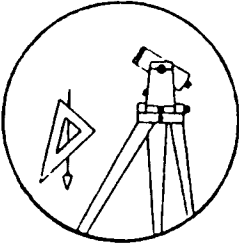

T-082

- Found
- New
- Reset
- Not Found
- Referenced
- Destroyed

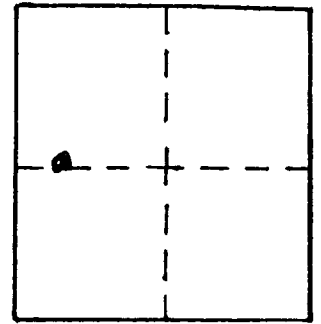

VERTICAL CONTROL

Elevation: 610.48 NGS Line # _____ USGS Line # _____ OSHD Line # _____

Precision: 3rd Agency: DCSO Proj. # 2007 Date: 1999

HORIZONTAL CONTROL CORPSCON6 NAVD88 613.99 FT. CS 66/37

South Zone O.C.S. 27: Y(Northing) _____ X(Easting) _____

South Zone O.C.S. 83: Y(Northing) 605287 X(Easting) 4196784

Precision: GIS SCALED Agency: DCSO Proj. # _____ Date: 2014

Approx. NAD 83 Geographic Position: Latitude 43° 17' 43" Longitude 123° 13' 15"

DESCRIPTION and TO REACH

DCSO DRILL CAP SET IN A 5 FT. DIA. MASS
OF CONCRETE,

FROM THE INTERSECTION OF WHISTLER PARK RD
(CO. RD # 244) AND SOUTH BANK RD. IN
T 26 S R 4 W SEC 18, PROCEED SOUTH WESTERLY
ALONG SOUTH BANK RD 1.2 MILES TO
MONUMENT ON RIGHT

Reference Marks:

