

OFFICE OF THE
DOUGLAS COUNTY SURVEYOR

Station: U-1 RESET T 26 S, R 6 W, Sec 31

Set By (Agency): DCSO

Date Set: 1974

Recovered By RWS, SJF


Date Recovered 5/11/89

Recovered By _____

Date Recovered _____

Recovered By _____

Date Recovered _____

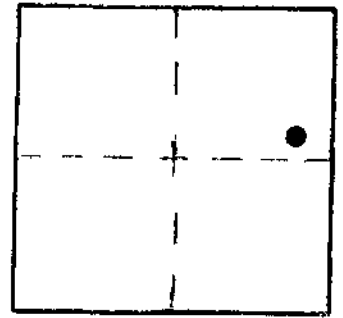

U-001 26S 6W 31
U-1 RESET

NAD 597159.59 4136196.14
83 43°16' 2" 123°26'54"

VERTICAL CONTROL NGVD 29

Elevation: 394.350 NGS Line # _____ USGS Line # _____ OSHD Line # _____

Precision: 2nd Agency: DCSO Proj. # 2007 Date: 1990

HORIZONTAL CONTROL OCS 27

South Zone State Plane Coordinates: Y(Northing) 597,194.71 X(Easting) 1,215,237.24

Precision: 1/25,000 Agency: DCSO Proj. # 2006 Date: 1974

Approximate Geographic Position: Latitude 43°16'03" Longitude 123°26'50"


DESCRIPTION and TO REACH

SKETCH

A DCSO disk stamped "U-1 RESET 1974" set in a 10ft. by 6ft. by 6ft. high rock outcrop.

From the intersection of Melrose Rd. (Co. Rd. #13) and Melqua Rd. (Co. Rd. #13A) in T27S, R6W, Sec. 6, proceed northeasterly along Melqua Rd. 1.6 miles to left hand curve in road and monument on left.

Reference Marks:

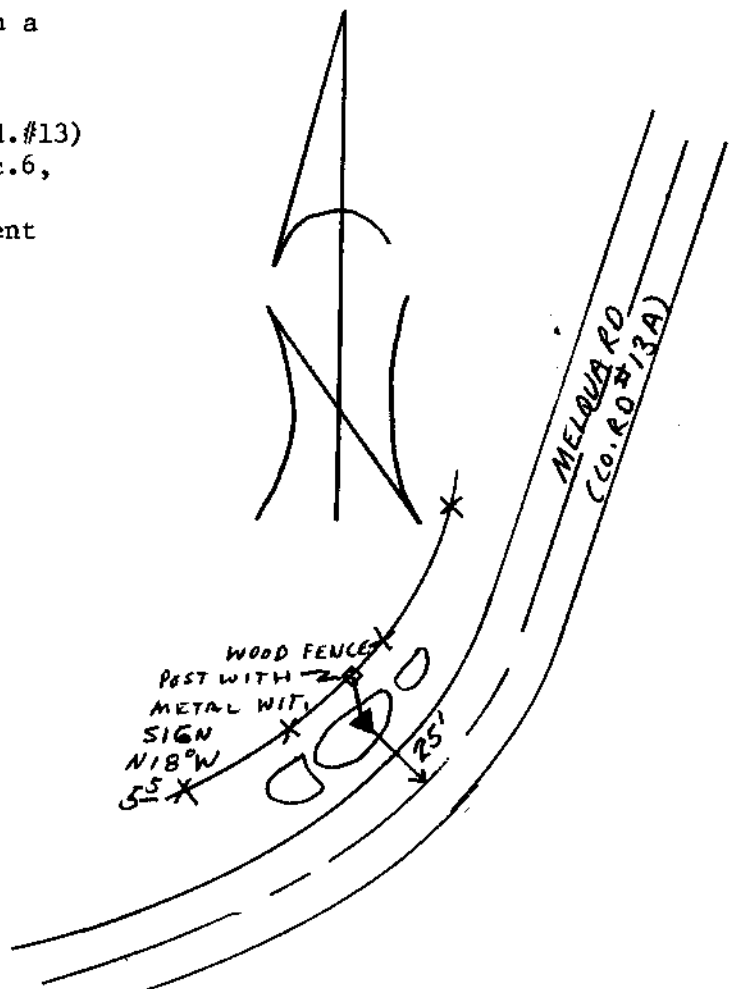

Note: For further information, contact the Douglas County Surveyor's Office, Room 205 Douglas County Justice Building, Roseburg, OR 97470. Phone 440-4278. Douglas County residents outside the Roseburg calling area, dial toll free 1-800-452-0991.