

DOUGLAS COUNTY SURVEYOR'S OFFICE


100-1108

Designation: U-029 Station: U-27 T 24 S R 7 W S 14 1/4 SE

Date Set: 1972 Set by (Agency): DCSO

Date Recovered: 3-13-03 Recovered by: RWS SJF

- Found New Reset
- Not Found Referenced Destroyed

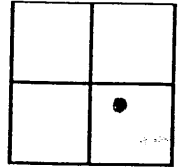

VERTICAL CONTROL

NGVD 29 Elevation: 247.56 Feet File # CS66/6A
 Precision: 3rd Agency: DCSO Project: 2007 Date: 2007
 NAVD 88 Elevation: _____ Meters File # _____
 Precision: _____ Agency: _____ Project: _____ Date: _____


HORIZONTAL CONTROL - south zone

N <u>675906.74</u>	E <u>1,206,762.11</u>	Datum/Adj.: <u>1927</u>	Precision: <u>1/25,000</u>
Lat: <u>43°28'56.8"</u>	Long: <u>123°29'22.0"</u>	Agency: <u>DCSO</u>	File # <u>2006</u> Date: <u>1972</u>
N <u>675,872.05</u>	E <u>412,7721.40</u>	Datum/Adj.: <u>NAO 93</u>	Precision: _____
Lat: <u>4°29'56"</u>	Long: <u>123°29'26"</u>	Agency: <u>DCSO</u>	File # _____ Date: _____
N _____	E _____	Datum/Adj.: _____	Precision: _____
Lat: _____	Long: _____	Agency: _____	File # _____ Date: _____
N _____	E _____	Datum/Adj.: _____	Precision: _____
Lat: _____	Long: _____	Agency: _____	File # _____ Date: _____

DESCRIPTION AND TO REACH

DCSO DRILL CAP STAMPED
"U-27 1972" SET IN TOP
OF 4'X3'X2' HIGH ROCK 1 FT
LOWER THAN ROAD

FROM THE INTERSECTION OF
WILLOCK ROAD (CO. RD #57) AND
COUGAR CREEK ROAD (CO. RD #57A)
IN T 24 S R 7 W SEC. 13 AT THE
WESTERLY END OF WILLOCK
BRIDGE OVER UMPQUA RIVER,
PROCEED SOUTHWESTERLY ALONG
COUGAR CREEK ROAD 0.6 MILES
TO MONUMENT ON LEFT.

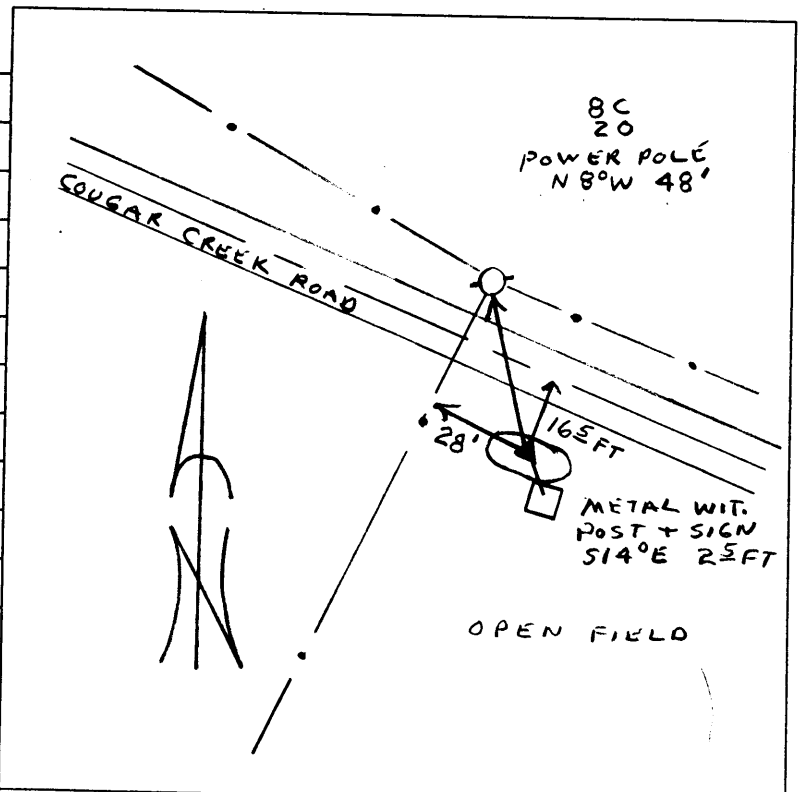



7. 27. 1999