


DOUGLAS COUNTY SURVEYOR'S OFFICE

100-1093

Designation: U-036 Station: U 34 T 24S R 7W S 3 $\frac{1}{4}$ NW

Date Set: 1972 Set by (Agency): DCSO

Date Recovered: 4-2-03 Recovered by: RWS, SJF

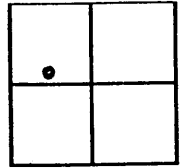

- Found
- Not Found
- New
- Referenced
- Reset
- Destroyed

VERTICAL CONTROL

NGVD 29 Elevation: 214.266 Feet File #: _____
 Precision: 2nd Agency: DCSO Project: 2006 Date: 1972
 NAVD 88 Elevation: _____ Meters File #: _____
 Precision: _____ Agency: _____ Project: _____ Date: _____


HORIZONTAL CONTROL - south zone

N 687,211.37 E 1,199,256.35 Datum/Adj.: 1927 Precision: 1/25,000
 Lat: _____ Long: _____ Agency: DCSO File # 2006 Date: 1972
 N 687176.60 E 4120215.92 Datum/Adj.: NAD 83 Precision: ?
 Lat: 43°30'45" Long: 123°31'14" Agency: DCSO File # ? Date: ?
 N _____ E _____ Datum/Adj.: _____ Precision: _____
 Lat: _____ Long: _____ Agency: _____ File # _____ Date: _____
 N _____ E _____ Datum/Adj.: _____ Precision: _____
 Lat: _____ Long: _____ Agency: _____ File # _____ Date: _____

DESCRIPTION AND TO REACH

DCSO DRILL CAP STAMPED
"U 34 1972" SET IN A
5' X 5' X 2' HIGH EXPLODED
ROCK LEVEL WITH ROAD
SURFACE.

FROM THE INTERSECTION OF
BULLOCK ROAD (CO. RD #57) AND
CUGAR CREEK ROAD (CO. RD #57C)
IN T24S, R7W, SEC 13 AT
TYEE, NEAR WESTERLY END
OF BULLOCK BRIDGE OVER UMPQUA
RIVER, PROCEED NORTHWESTERLY
ALONG BULLOCK ROAD 3.20 MILES
TO MONUMENT ON LEFT.

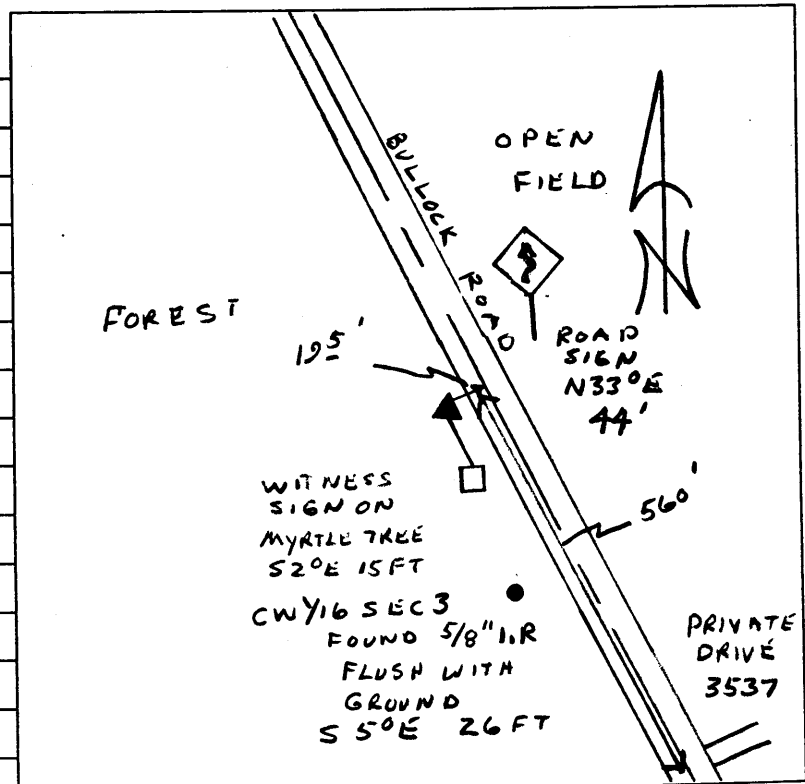

560' 26 FT



7.26.1999