

OFFICE OF THE  
DOUGLAS COUNTY SURVEYOR


Station: U54  
 Set By (Agency): DCSO  
 Date Set: 1972  
 Recovered By RWS,SJF  
 Date Recovered 4/28/87  
 Recovered By \_\_\_\_\_  
 Date Recovered \_\_\_\_\_  
 Recovered By \_\_\_\_\_  
 Date Recovered \_\_\_\_\_

T 22 S, R 7 W , Sec 31



u-055  
U 54

NAD 726544.28 4105472.45  
83 43°37' 8" 123°34'53"

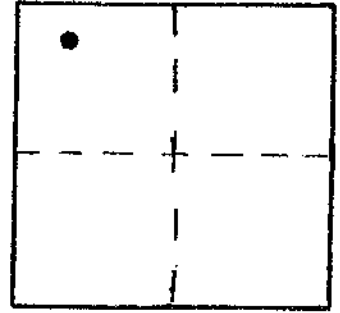

VERTICAL CONTROL

Elevation: \_\_\_\_\_ NGS Line # \_\_\_\_\_ USGS Line # \_\_\_\_\_ OSHD Line # \_\_\_\_\_  
 Precision: \_\_\_\_\_ Agency: \_\_\_\_\_ Proj. # \_\_\_\_\_ Date: \_\_\_\_\_

HORIZONTAL CONTROL

South Zone State Plane Coordinates: Y(Northing) 726,579.19 X(Easting) 1,184,512.25  
 Precision: 1/10,000 Agency: DCSO Proj. # 2006 Date: 1972  
 Approximate Geographic Position: Latitude 43°37'09" Longitude 123°34'49"


DESCRIPTION and TO REACH

SKETCH

A DCSO disk stamped "U54 1972" set flush in a 3 1/2' X 2' X 1 1/2' portion of a rock outcrop.

TO REACH:

From the intersection of Henderer Rd.  
 (Co. Rd. #118) and Mehl Creek Rd.  
 (Co. Rd. #11) in T22S,R7W,Sec.30,  
 proceed southerly along Mehl Creek Rd.  
 1.0 miles to monument on right.

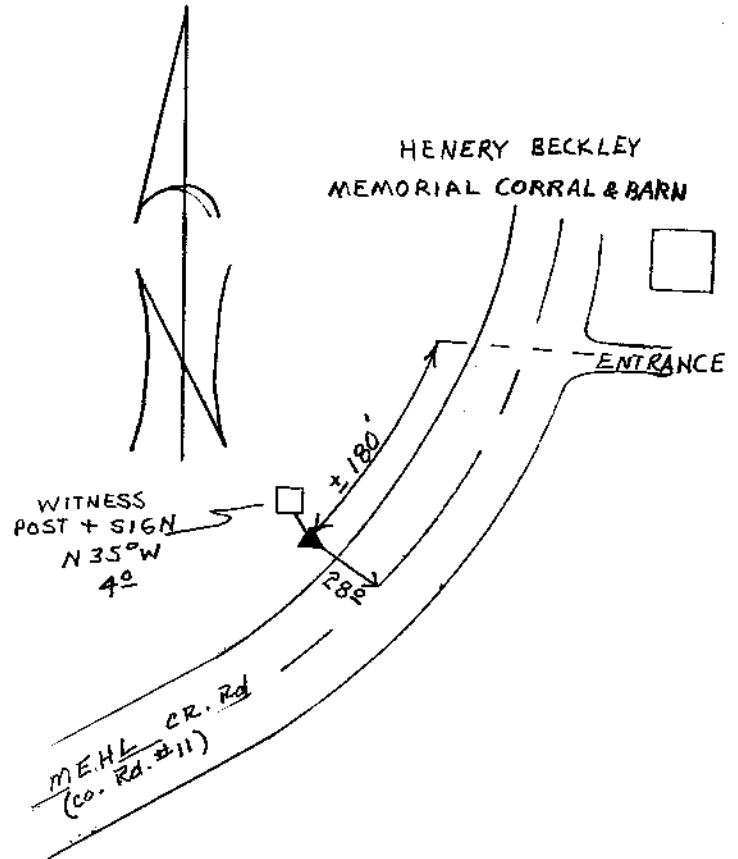

Reference Marks:

Note: For further information, contact the Douglas County Surveyor's Office, Room 205 Douglas County Justice Building, Roseburg, OR 97470. Phone 440-4278. Douglas County residents outside the Roseburg calling area, dial toll free 1-800-452-0991.