

OFFICE OF THE
DOUGLAS COUNTY SURVEYOR

Station: U57 T 22 S, R 8 W, Sec 24

Set By (Agency): DCSO

Date Set: 1972

Recovered By RWS, SJF


Date Recovered 4/28/87

Recovered By 10/98 DCSO

Date Recovered _____

Recovered By _____

Date Recovered _____

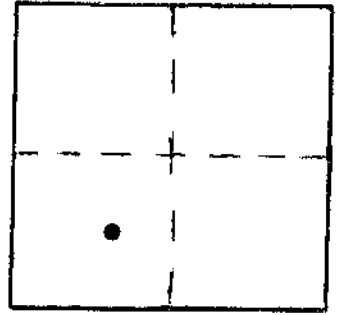

U-058
U 57

NAD 734327.62 4101204.15
83 43°38'24" 123°35'55"

VERTICAL CONTROL

Elevation: 253⁴⁹ NGS Line # _____ USGS Line # _____ OSHD Line # _____

Precision: 3rd Agency: DCSO Proj. # CS 66/52 Date: 1998

HORIZONTAL CONTROL

South Zone State Plane Coordinates: Y(Northing) 734,362.52 X(Easting) 1,180,243.90

Precision: 1/10,000 Agency: DCSO Proj. # 2006 Date: 1972

Approximate Geographic Position: Latitude 43°38'24" Longitude 123°35'50"


DESCRIPTION and TO REACH

SKETCH

A DCSO disk stamped "U57 1972" set in an
8 in. dia. concrete filled belltile protruding
8 in. above ground.

TO REACH:

From the intersection of Henderer Rd. (Co. Rd. #118)
and Mehl Creek Rd. (Co. Rd. #11)
in T22S, R7W, Sec. 30, proceed westerly
along Henderer Rd. 1.60 miles to
monument on right.

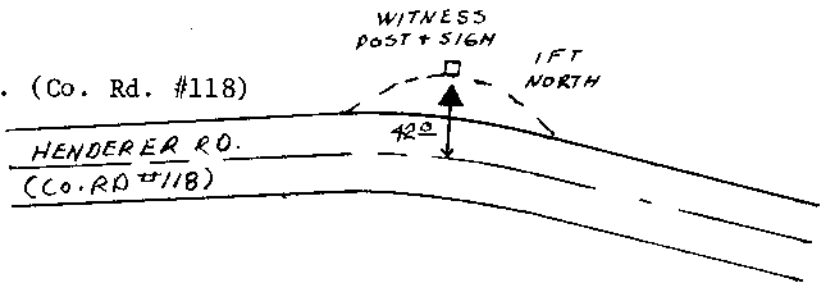

Reference Marks:

Note: For further information, contact the Douglas County Surveyor's Office, Room 205
Douglas County Justice Building, Roseburg, OR 97470. Phone 440-4278. Douglas
County residents outside the Roseburg calling area, dial toll free 1-800-452-0991.