


OFFICE OF THE

u-061
U 60

22S 8W 15

DOUGLAS COUNTY SURVEYOR

NAD 738540.42 4091185.12
83 43°39' 2" 123°38'13"

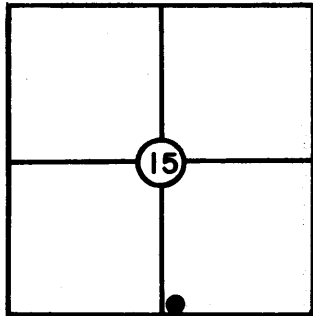

T 22 S, R 8W, Sec. 15

Station: U 60

Set By (Agency): DCSO

Date: 1972

VERTICAL CONTROL

NGVD 29

Elevation: 182.564 NGS(USC&GS) Line # _____ USGS Line # _____

Order

Of Precision 2nd Agency: DCSO Proj. #: 2006 Date: 1972

HORIZONTAL CONTROL

NAD 27

Oregon State Plane Coordinates: Y(Northing) 738,575.29 X(Easting) 1,170,224.84
(South Zone)

Order

Of Precision 1/10,000 Agency: DCSO Proj. #: 2006 Date: 1972

Approximate Geographic Position: Latitude= _____ Longitude= _____

DESCRIPTION: Brass cap set in concrete tile

located on top of cut bank approx. 60ft.


above road surface and 40ft. N. of N. edge

of pavement.

VICINITY: Approx. 3.8 mi. W. of Elkton on

Hwy. 38.

SKETCH

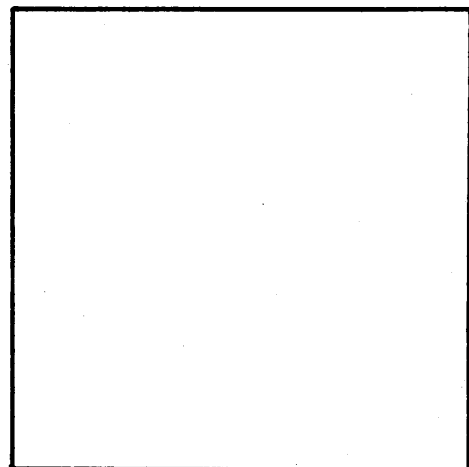

NOTE: For Possible Further Information On This Station, Please Contact The Douglas County Surveyors Office, Rm. 205 Douglas County Justice Bldg., Roseburg, OR. 97470 Phone 672-3311 Ext. 272.. Douglas County residents outside the Roseburg calling area dial toll free 1-800-452-0991.