

OFFICE OF THE
DOUGLAS COUNTY SURVEYOR

Station: U63 T 22 S, R 8 W, Sec 29

Set By (Agency): DCSO

Date Set: 1972

Recovered By RWS, SJF


Date Recovered 4/28/87 (FPOK 1991)

Recovered By DCSO 10/98

Date Recovered _____

Recovered By _____

Date Recovered _____

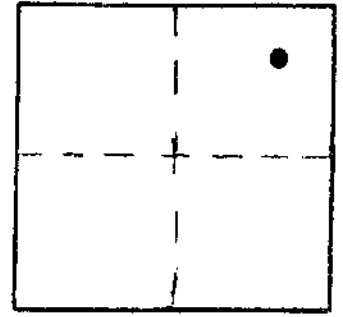

U-064
U 63

NAD 732412.07 4082528.93
83 43°37'58" 123°40' 8"

VERTICAL CONTROL

Elevation: 124.45 NGS Line # _____ USGS Line # _____ OSHD Line # _____

Precision: 3rd Agency: DCSO Proj. # 66/52 Date: 1998

HORIZONTAL CONTROL

South Zone State Plane Coordinates: Y(Northing) 732,446.92 X(Easting) 1,161,568.67

Precision: 1/10,000 Agency: DCSO Proj. # 2006 Date: 1972

Approximate Geographic Position: Latitude 43°37'58" Longitude 123°40'04"


DESCRIPTION and TO REACH

A DCSO disk stamped "U63 1972" set in an 8 in. dia. concrete filled belltile protruding 6 in. above ground.

SKETCH

TO REACH:

From the intersection of Henderer Rd. (Co. Rd. #118) and Bridge Rd. (BLM Rd. #22-8-29.1) in T22S, R8W, Sec. 29, proceed northwesterly along Henderer Rd. 0.2 miles to monument on left.

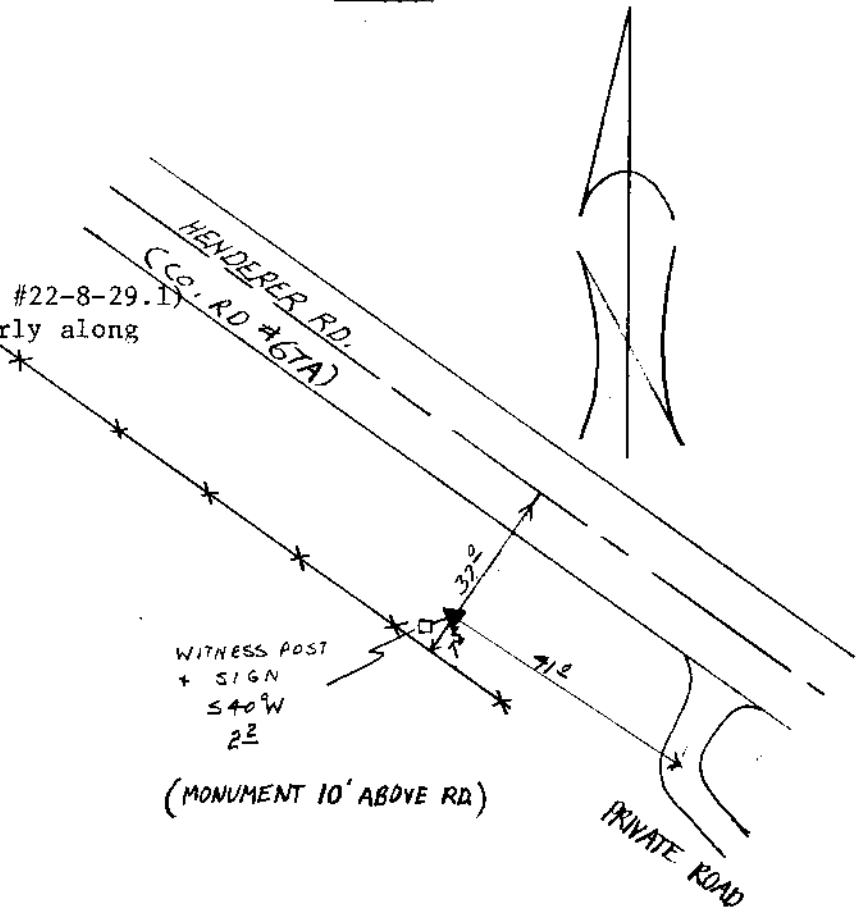

Reference Marks:

Note: For further information, contact the Douglas County Surveyor's Office, Room 205 Douglas County Justice Building, Roseburg, OR 97470. Phone 440-4278. Douglas County residents outside the Roseburg calling area, dial toll free 1-800-452-0991.