

OFFICE OF THE
DOUGLAS COUNTY SURVEYOR

Station: U-76 T 22 S, R 10W, Sec 24

Set By (Agency): DCSO

Date Set: 1973

Recovered By GQ-RS


Date Recovered 2-16-82

Recovered By _____

Date Recovered _____

Recovered By _____

Date Recovered _____

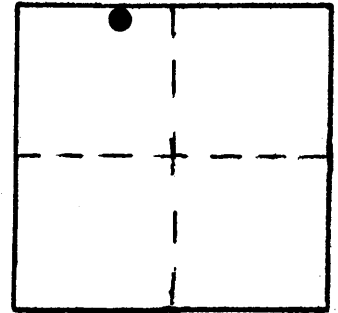

u-078
U-76

22S 10W 24

NAD 740327.75 4037901.39
83 43°38'59" 123°50'19"

U-078

VERTICAL CONTROL NGVD 29

Elevation: 19.888 NGS Line # _____ USGS Line # _____ OSHD Line # _____

Precision: 3rd Agency: DCSO Proj. # 2006 Date: 1972

HORIZONTAL CONTROL NAD 27

South Zone State Plane Coordinates: Y(Northing) 740,362.47 X(Easting) 1,116,941.03

Precision: 1/10,000 Agency: DCSO Proj. # 2006 Date: 1973


Approximate Geographic Position: Latitude 43°39'00" Longitude 123°50'14"

DESCRIPTION and TO REACH

SKETCH

Found: A standard DCSO disk set in concrete tile stamped "U-76 1973". Survey marker along side.

To reach: Monument is located at Scottsburg County Park off of Hwy. #38 approx. 1 mi. Westerly of Scottsburg Post Office.

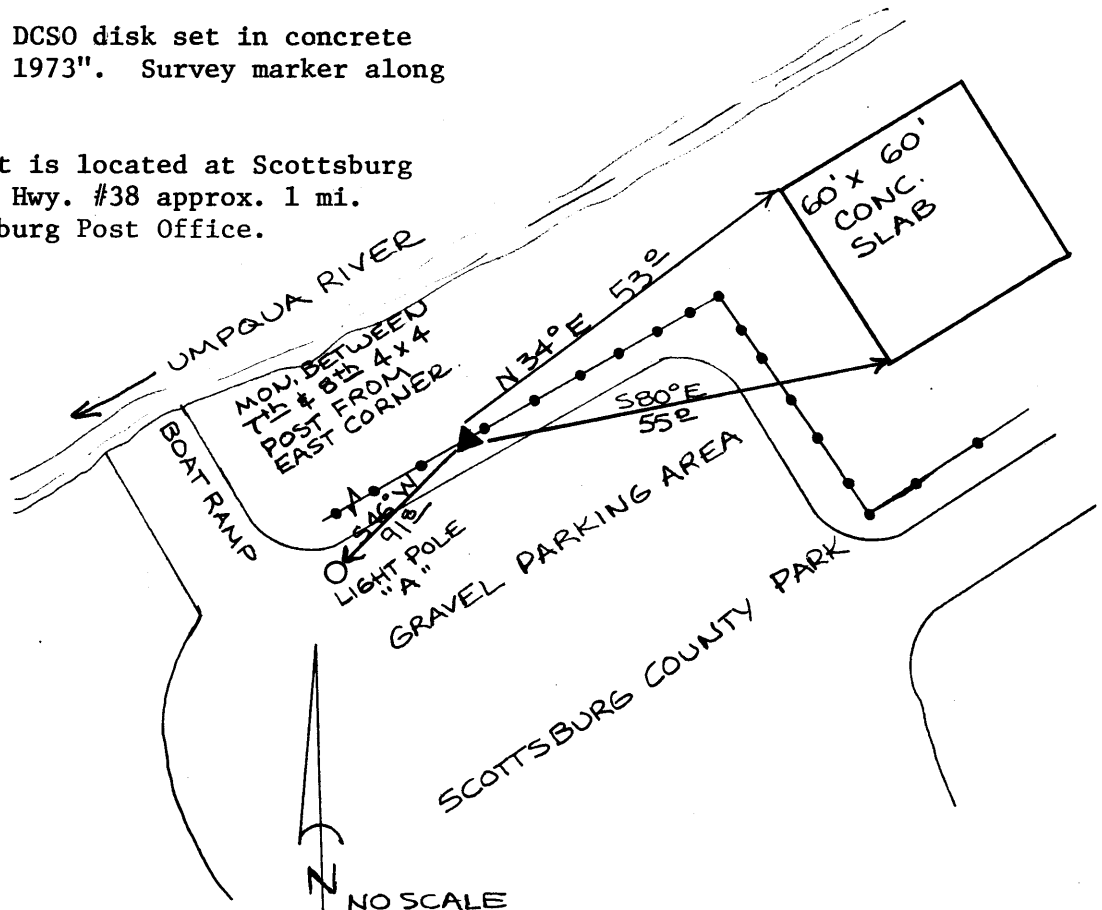

Reference Marks:

Note: For further information, contact the Douglas County Surveyor's Office, Room 205 Douglas County Justice Building, Roseburg, OR 97470. Phone 440-4278. Douglas County residents outside the Roseburg calling area, dial toll free 1-800-452-0991.