

OFFICE OF THE
DOUGLAS COUNTY SURVEYOR

Station: U 76

T 30 S, R 9 W, Sec 2

Set By (Agency): USC&GS

Date Set: 1931

Recovered By PB,RS


Date Recovered 11/16/83

Recovered By _____


Date Recovered _____

Recovered By _____

Date Recovered _____

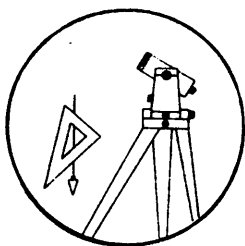

U-079

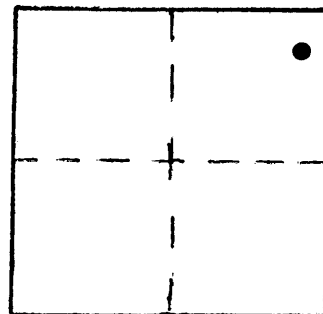

VERTICAL CONTROL **NGVD 29**

Elevation: 1,037.498 NGS Line # 27 USGS Line # _____ OSHD Line # _____

Precision: 2nd Agency: USC&GS Proj. # _____ Date: 1957

HORIZONTAL CONTROL

South Zone State Plane Coordinates: Y(Northing) _____ X(Easting) _____

Precision: _____ Agency: _____ Proj. # _____ Date: _____

Approximate Geographic Position: Latitude _____ Longitude _____

DESCRIPTION and TO REACH


SKETCH

DESCRIPTION:

A disk stamped "U 76 1931" set flush in a 10 in. square concrete post 6 in. above ground.

TO REACH:

From the intersection of State Hwy. 42 and Signal Tree L.O. Rd. (BLM #29-9-36.0) in T30S, R9W, Sec.1, proceed southwesterly along State Hwy. 42 0.35 miles to monument on right.

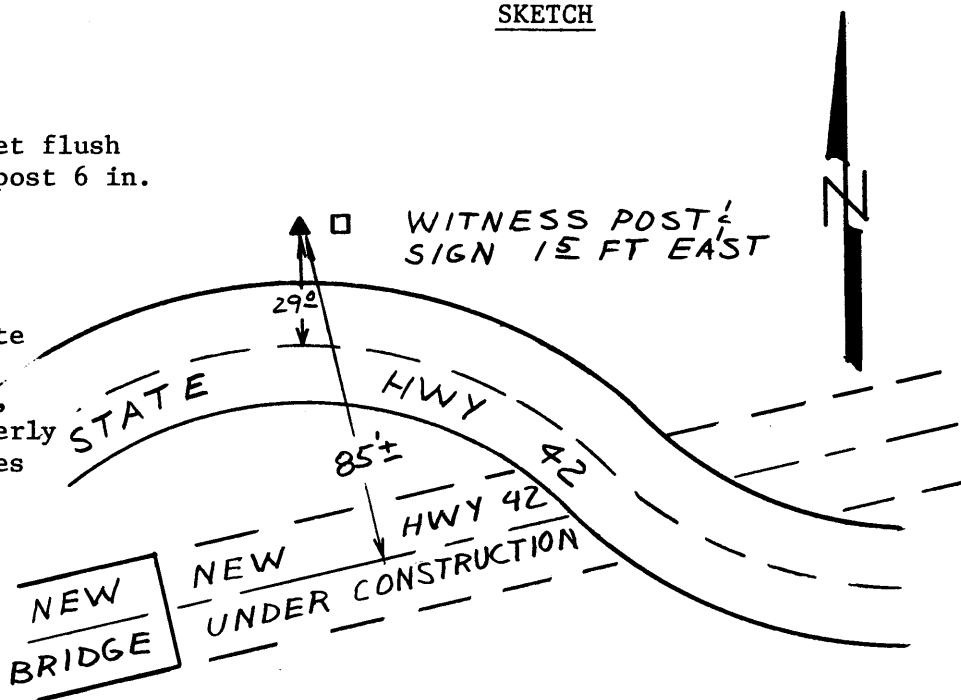

Reference Marks:

Note: For further information, contact the Douglas County Surveyor's Office, Room 205 Douglas County Justice Building, Roseburg, OR 97470. Phone 440-4278. Douglas County residents outside the Roseburg calling area, dial toll free 1-800-452-0991.