


OFFICE OF THE  
DOUGLAS COUNTY SURVEYOR

Station: U-91  
 Set By (Agency): DCSO  
 Date Set: 1973  
 Recovered By GQ-TP  
 Date Recovered 2-82  
 Recovered By \_\_\_\_\_  
 Date Recovered \_\_\_\_\_  
 Recovered By \_\_\_\_\_  
 Date Recovered \_\_\_\_\_

T 21 S, R 11W, Sec 32

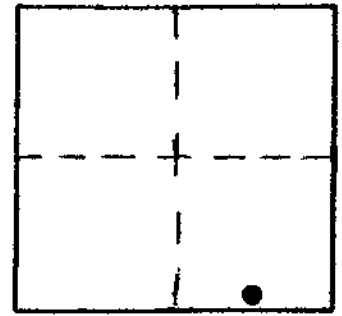

u-094 215 11W 32  
 U-91  
 NAD 759361.94 3986377.18  
 83 43°41'46" 124° 2'10"

VERTICAL CONTROL

Elevation: 8.842 NGS Line # \_\_\_\_\_ USGS Line # \_\_\_\_\_ OSHD Line # \_\_\_\_\_  
 Precision: 2nd Agency: DCSO Proj. # 2006 Date: 1973

HORIZONTAL CONTROL


South Zone State Plane Coordinates: Y(Northing) 759,396.76 X(Easting) 1,065,416.33  
 Precision: 1/20,000 Agency: DCSO Proj. # 2006 Date: 1973  
 Approximate Geographic Position: Latitude 43°41'46" Longitude 124°02'05"

DESCRIPTION and TO REACH

SKETCH

Found: A standard DCSO disk set in a 12" x 18" x 20" rock 6' lower than the pavement, stamped "U-91 1973".

To reach: From the intersection of Hwy 38 & Co. Rd. #55 ( in sec. 1 T22S R12W) proceed Easterly 1.65 miles along Hwy. 38 to monument on the right.

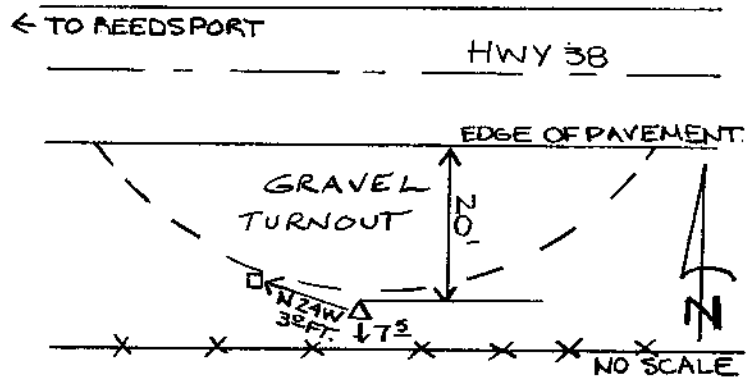

Reference Marks:

Note: For further information, contact the Douglas County Surveyor's Office, Room 205 Douglas County Justice Building, Roseburg, OR 97470. Phone 440-4278. Douglas County residents outside the Roseburg calling area, dial toll free 1-800-452-0991.