

OFFICE OF THE
DOUGLAS COUNTY SURVEYOR

Station: U-255 T 32 S, R 5W, Sec 20

Set By (Agency): USC&GS

Date Set: 1934

Recovered By LEM



Date Recovered 1-82

Recovered By _____

Date Recovered _____

Recovered By _____

Date Recovered _____

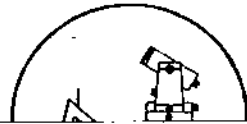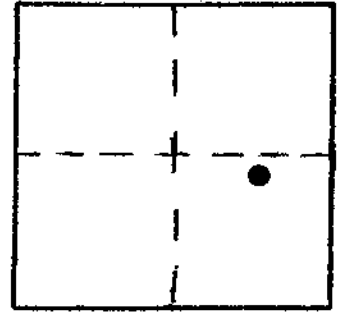

u-102 32S 5W 20
U 255

NAD 416378.53 4166679.59
83 42°46'28" 123°18'40"

VERTICAL CONTROL

Elevation: 1556.19 NGS Line # _____ USGS Line # _____ OSHD Line # 310

Precision: 3rd Agency: OSHD Proj. # _____ Date: 1957

HORIZONTAL CONTROL

South Zone State Plane Coordinates: Y(Northing) 416,414.70 X(Easting) 1,245,720.93

Precision: 1/25,000 Agency: DCSO Proj. # 2006 Date: 1973


Approximate Geographic Position: Latitude 42°46'28" Longitude 123°18'36"

DESCRIPTION and TO REACH

SKETCH

Found: A standard USC&GS disk set in concrete block. Disk is stamped "U255 1555 1934".

To reach: From the intersection of Co. Rd. #12 (Azalea-Glen Rd.) and Co. Rd. #96 (Quines Creek Rd.) in T32S R5W sec. 22 proceed Wēsterly along Co. Rd. #12 1.95 miles to monument on the right.

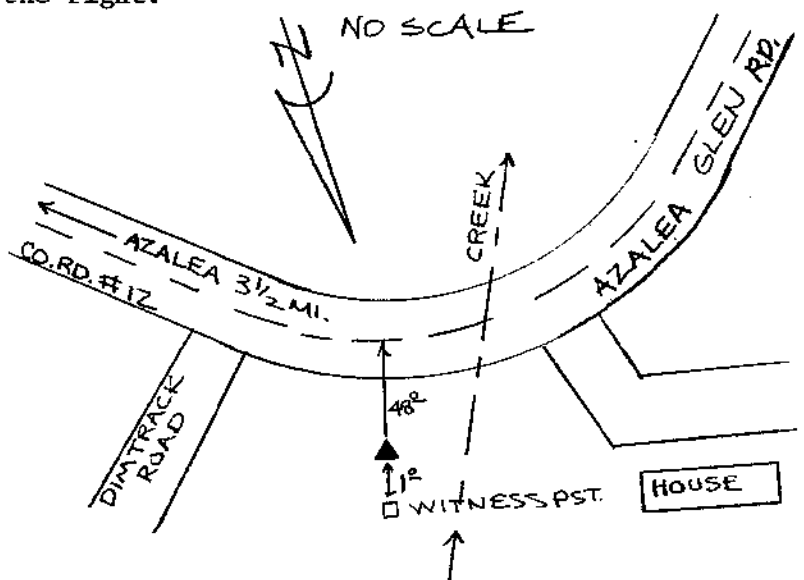

Reference Marks:

Note: For further information, contact the Douglas County Surveyor's Office, Room 205 Douglas County Justice Building, Roseburg, OR 97470. Phone 440-4278. Douglas County residents outside the Roseburg calling area, dial toll free 1-800-452-0991.