



OFFICE OF THE  
DOUGLAS COUNTY SURVEYOR

U-105

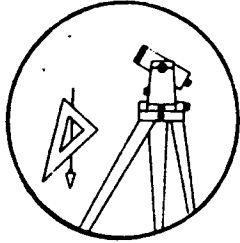

Station: U 499 T 30 S, R 4W, Sec 8  
 Set By (Agency): 1949  
 Date Set: USC&GS  
 Recovered By JP&RS  
 Date Recovered 3-17-82  
 Recovered By \_\_\_\_\_  
 Date Recovered \_\_\_\_\_  
 Recovered By \_\_\_\_\_  
 Date Recovered \_\_\_\_\_

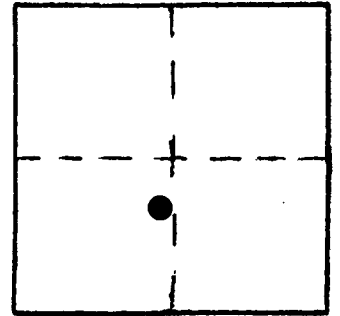

VERTICAL CONTROL CORPSCON6 NAVD88 748.983 FT.  
 Elevation: 745.602 NGS Line # 130 USGS Line # \_\_\_\_\_ OSHD Line # \_\_\_\_\_  
 Precision: 2nd Agency: USC&GS Proj. # \_\_\_\_\_ Date: 1957


HORIZONTAL CONTROL  
 South Zone State Plane Coordinates: Y(Northing) 488120 X(Easting) 4199356  
 Precision: GIS SCALED Agency: DCSO Proj. # \_\_\_\_\_ Date: 2014  
 Approximate Geographic Position: Latitude \_\_\_\_\_ Longitude \_\_\_\_\_

DESCRIPTION and TO REACH

SKETCH

Found: A standard USC&GS disk set in a 12" concrete post, set flush with the ground approx. 1 ft. above the road surface. Disk is stamped "U 499 1949".

To reach: From the junction of St. Hwy. #227 and Co. Rd. #42 (Days Creek Cut off) in T30S R4W sec. 7, proceed Easterly along St. Hwy. #227 0.9 miles to station on the right. (or southerly side of road).

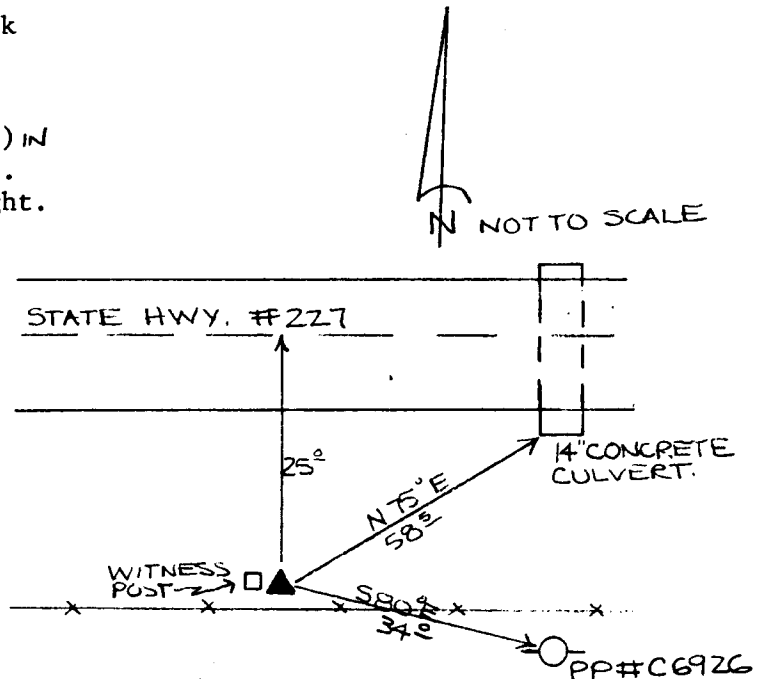

Reference Marks:

Note: For further information, contact the Douglas County Surveyor's Office, Room 205 Douglas County Justice Building, Roseburg, OR 97470. Phone 440-4278. Douglas County residents outside the Roseburg calling area, dial toll free 1-800-452-0991.