


OFFICE OF THE  
DOUGLAS COUNTY SURVEYOR

U-110

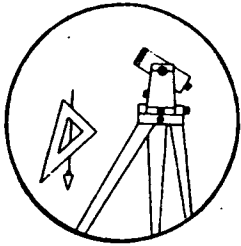

Station: U 610 T 29 S, R 5 W. , Sec 18

Set By (Agency): OSHD

Date Set: 1967

Recovered By RWS, SJF


Date Recovered 2/25/85

Recovered By \_\_\_\_\_

Date Recovered \_\_\_\_\_

Recovered By \_\_\_\_\_

Date Recovered \_\_\_\_\_

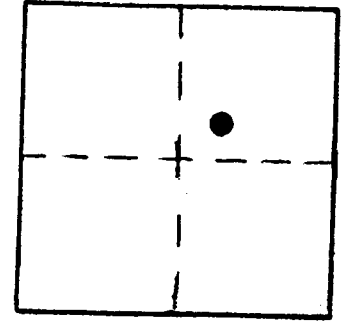

VERTICAL CONTROL

Elevation: 587.84 NGS Line # \_\_\_\_\_ USGS Line # \_\_\_\_\_ OSHD Line # 369

Precision: 3rd Agency: OSHD Proj. # \_\_\_\_\_ Date: 1977

HORIZONTAL CONTROL CORPSCON6 NAVD88 591.28 FT.

South Zone State Plane Coordinates: Y(Northing) 516830 X(Easting) 4164794

Precision: GIS SCALED Agency: DCSO Proj. # \_\_\_\_\_ Date: 2014


Approximate Geographic Position: Latitude \_\_\_\_\_ Longitude \_\_\_\_\_

DESCRIPTION and TO REACH

An OSHD disk stamped "U 610 1967"  
set in a 1' x 1' concrete post  
1" above ground.

From the Myrtle Creek I-5  
northbound on-ramp (Exit 108) in  
T. 29 S., R. 5 W., Sec. 28,  
proceed northerly along I-5 approx.  
2.6 miles, past state truck scales,  
to monument on right.

SKETCH

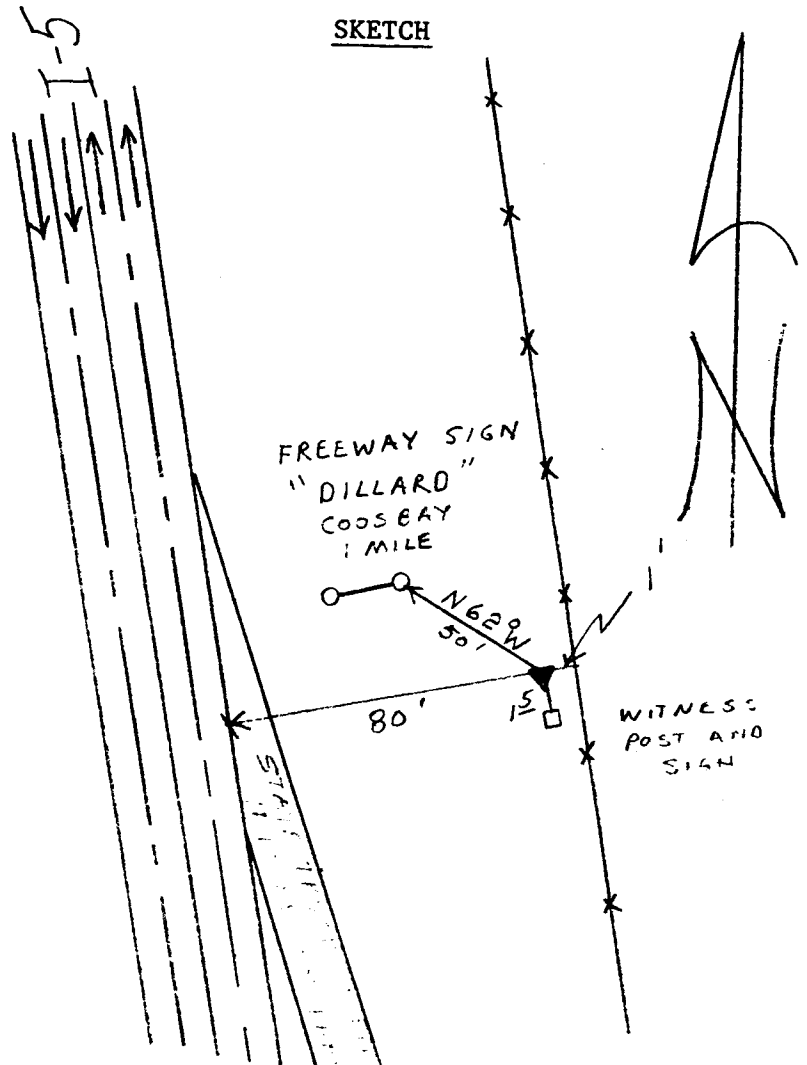

Reference Marks:

Note: For further information, contact the Douglas County Surveyor's Office, Room 205  
Douglas County Justice Building, Roseburg, OR 97470. Phone 440-4278. Douglas  
County residents outside the Roseburg calling area, dial toll free 1-800-452-0991.