


U-111

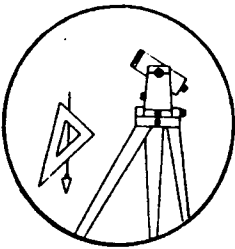

Set By (Agency): OSHD

Date Set: 1966

Recovered By RWS, SJF


Date Recovered JAN. 29, 1985

Recovered By _____

Date Recovered _____

Recovered By _____

Date Recovered _____

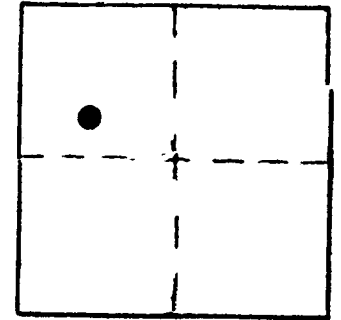

VERTICAL CONTROL CORPSCON6 NAVD88 1102.71 FT.

Elevation: 1099.29 NGS Line # _____ USGS Line # _____ OSHD Line # 369

Precision: 3rd Agency: OSHD Proj. # _____ Date: 1980

HORIZONTAL CONTROL

South Zone State Plane Coordinates: Y(Northing) 453339 X(Easting) 4186382

Precision: GIS SCALED Agency: DCSO Proj. # _____ Date: 2014

Approximate Geographic Position: Latitude _____ Longitude _____

DESCRIPTION and TO REACH

SKETCH


DESCRIPTION:

A OSHD disk stamped "U 615 1968" set in 6 inch diameter concrete post protruding 3 inches above ground.

TO REACH:

From the Azalea exit of I-5 (exit 88) in T32S, R5W, Sec. 11, proceed north-erly along I-5 approx. 6.0 miles to monument on right.

From the Richie Rd. overcrossing of I-5 (exit 95) in T31S, R5W, Sec. 2, proceed southerly along I-5 approx. 2.3 miles to monument on left across freeway.

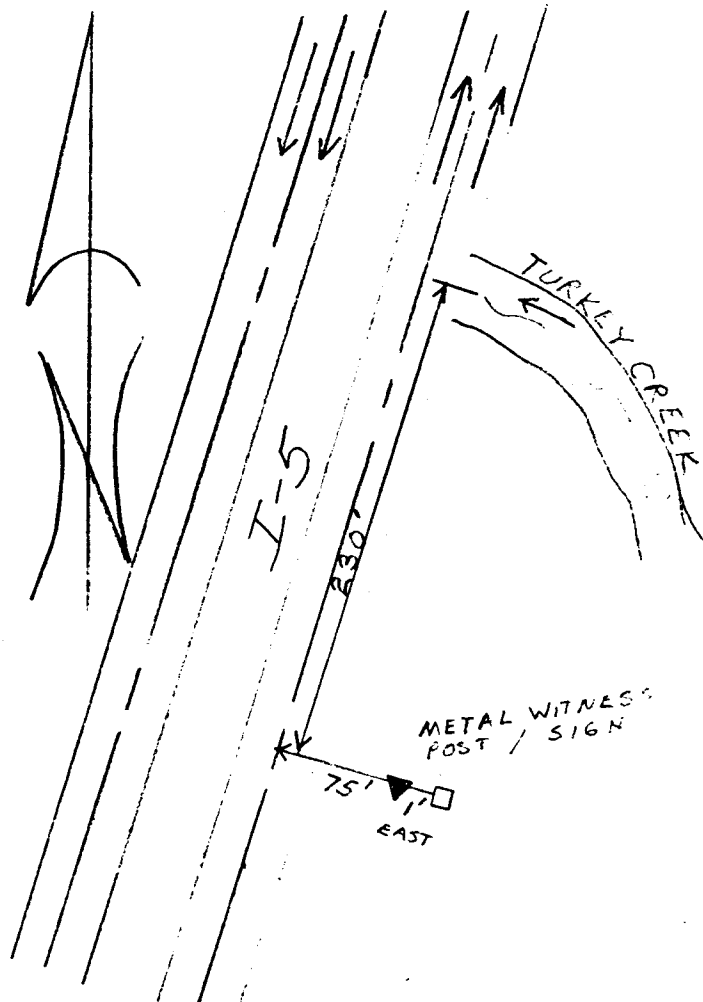

Reference Marks:

Note: For further information, contact the Douglas County Surveyor's Office, Room 205 Douglas County Justice Building, Roseburg, OR 97470. Phone 440-4278. Douglas County residents outside the Roseburg calling area, dial toll free 1-800-452-0991.