

OFFICE OF THE
DOUGLAS COUNTY SURVEYOR

Station: U 738

T21S R4W Sec. 19

Date Set: 1987

Set By (Agency): NGS

DCSO Designation: U-140

Date Recovered: _____



Recovered By: _____

Date Recovered: _____

Recovered By: _____

Date Recovered: _____

Recovered By: _____

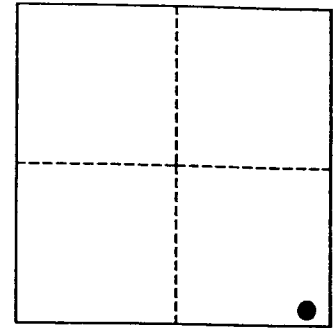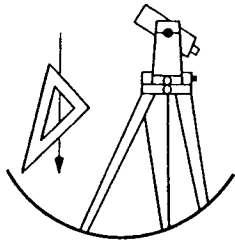

VERTICAL CONTROL

~~NGVD 29~~ ^{NAVD 88} Elevation: 403.894 FEET NAVD 88 Elevation: 123.107 METERS

NGS Line # L25035 USGS LINE # _____ OSHD Line # _____ FILE # _____

Precision: 1ST ORDER Agency: NGS Proj: _____ Date: 1988

HORIZONTAL CONTROL

O.C.S. 27 Y(Northing): _____ O.C.S. 83 Y(Northing): 760478

(South Zone) X(Easting): _____ (South Zone) X(Easting): 4205383

Precision: G/S SCALED Agency: DCSO Proj: _____ Date: 2014

Approx. O.C.S. 27 Geographic Position: Latitude: 43°43'18" Longitude: 123°12'26"

Approx. O.C.S. 83 Geographic Position: Latitude: _____ Longitude: _____

Found: A 3 - 5/8 inch diameter NGS disk stamped "U 738 1987" set flush and vertically in face of concrete support column of freeway underpass. Monument is approx. 4 feet above road elevation.

To reach: At the undercrossing of Bear Creek Rd. (Co. Rd. #62) and I-5, i.e. exit 163 (T21S R4W Sec. 19)

