

U-145 OFFICE OF THE
DOUGLAS COUNTY SURVEYOR



Station: U-2 RM2 T 26 S, R 6W, Sec 29


Date Set: 1983

Set By (Agency): DCSO

Date Recovered: 5-12-97; ~~11-10-98~~

Recovered By: RWS

- Found
- New
- Reset
- Not Found
- Referenced
- Destroyed

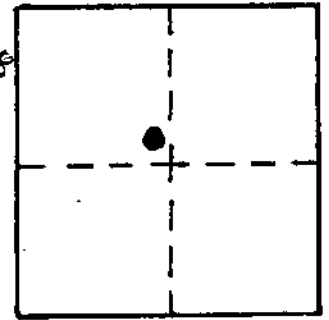

VERTICAL CONTROL NGVD 29

Elevation: 411.60 NGS Line # _____ USGS Line # _____ OSHD Line # _____
Precision: 3rd Agency: DCSO Proj. # 2007 Date: 1990
Corrected 9/2002

HORIZONTAL CONTROL

South Zone O.C.S. 27: Y(Northing) 602,213.09 X(Easting) 1,218,207.18
South Zone O.C.S. 83: Y(Northing) _____ X(Easting) _____
Precision: 1/25,000 Agency: DCSO Proj. # 2006 Date: 1974
Approx. NAD ⁸³/₂₁ Geographic Position: Latitude 43°16'54" Longitude 123°26'12"

DESCRIPTION and TO REACH

A DCSO DISK STAMPED "U-2 RM2 1983" SET IN A CONCRETE
FILLED BELLTILE.

GO TO THE INTERSECTION OF GARDEN VALLEY ROAD
AND OLD GARDEN VALLEY ROAD IN T26S R6W SEC. 29.
MONUMENT IS SOUTH WEST OF INTERSECTION

NOTE: MONUMENTS U-2 AND U-2 RM1 ARE
DESTROYED

Reference Marks:

