

OFFICE OF THE
DOUGLAS COUNTY SURVEYOR

Station: V 10

T21W R5W Sec. 34

Date Set: 1920

Set By (Agency): USC&GS

DCSO Designation: V-002

Date Recovered: 8-93



Recovered By: RWS SJF

Date Recovered: _____

Recovered By: _____

Date Recovered: _____

Recovered By: _____

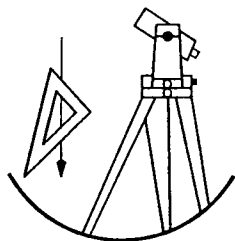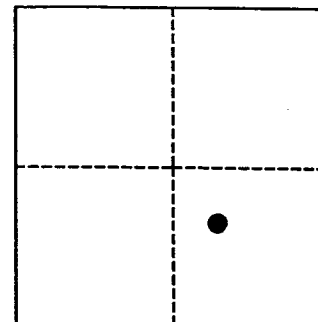

VERTICAL CONTROL

NGVD 29 Elevation: 327.690 FEET

CORPCON 6 NAVD 88 331.335 FT
NAVD 88 Elevation: 100.991 METERS

NGS Line # L25035 USGS LINE # _____

OSHD Line # _____ FILE # _____

Precision: 1ST ORDER Agency: CGS Proj: _____ Date: 1988

HORIZONTAL CONTROL

O.C.S. 27 Y(Northing): _____

O.C.S. 83 Y(Northing): 752377

(South Zone) X(Easting): _____

(South Zone) X(Easting): 4187762


Precision: GIS SCALED Agency: DCSO Proj: _____ Date: 2014

Approx. O.C.S. 27 Geographic Position: Latitude: 43°41'52" Longitude: 123°16'22"

Approx. O.C.S. 83 Geographic Position: Latitude: _____ Longitude: _____

Found: A 3 - 1/2 inch diameter USC&GS disk "ELEV. 327.302 Ft 20 V 10" set flush in the southeast corner of a concrete abutment of SPRR bridge over Pass Creek.

To reach: Go to the intersection of State Hwy 38 and Rock Creek Rd. (Co. Rd. #178A) in T21S R5W Sec. 34, SPRR bridge and monument is S25°E approx. 750 feet.

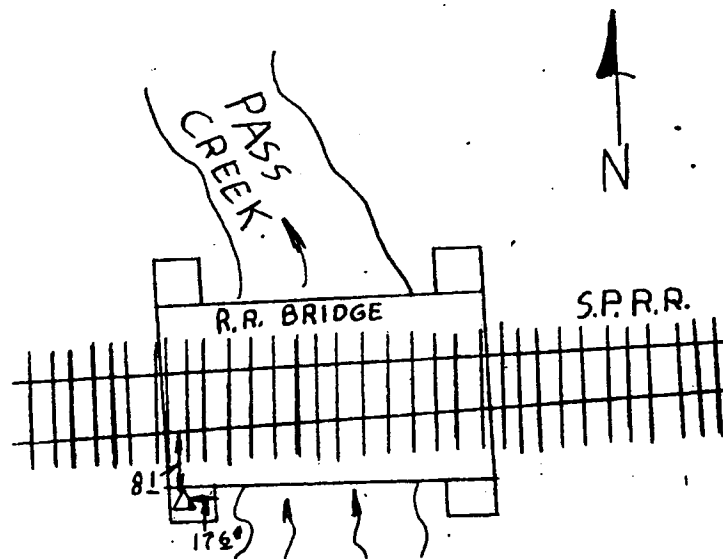

Note: For further information contact the Douglas County Surveyors Office, Room 205 Douglas County Justice Building, Roseburg, OR 97470. Phone 440-4272. Douglas County Residents outside Roseburg calling area, dial toll free 1-800-477-0991.