


W - 007

OFFICE OF THE
DOUGLAS COUNTY SURVEYOR

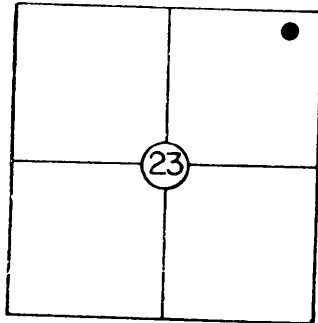

T 25 S, R 6W, Sec. 23

Station: W 495

Set By (Agency): USC & GS

Date: 1942

VERTICAL CONTROL

Elevation: 462.217

NGS(USC&GS) Line # 98

USGS Line #

CORPSCONG NAVD88 465.707 FT.

Order

Of Precision 2nd

Agency: USC & GS Proj. #:

Date: 1956

HORIZONTAL CONTROL

Oregon State Plane Coordinates: Y(Northing) 638453 X(Easting) 4156174
(South Zone)

Order

Of Precision

GIS
SCALED

Agency: DCSO Proj. #:


Date: 2014

Approximate Geographic Position: Latitude=

Longitude=

DESCRIPTION: 0.7 MI. W. OF JUNCTION OF
UMPQUA RD. AND ROAD LEADING N. TO KELLOGG
NEAR LARGE BARN ON SOUTHSIDE OF THE RD.,
40 FT. S. OF THE CENTERLINE OF THE RD. 30
FT. S.E. OF TUTHILLS MAIL BOX, 5 FT. E.
OF A GATE, 2 FT. N. OF A FENCELINE. A
STANDARD DISK STAMPED " W 495 1942" IN A
CONCRETE POST.

SKETCH

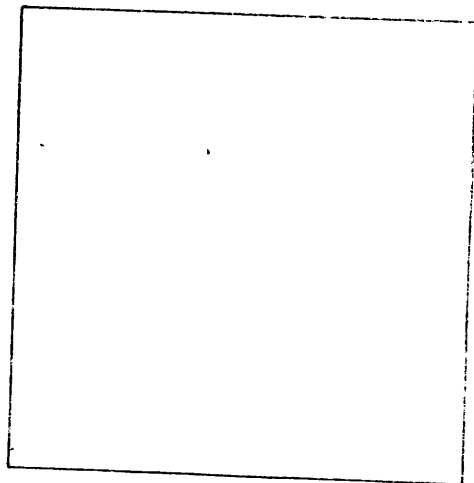

VICINITY: 3.1 MI. W. ALONG UMPQUA RD. FROM
SPRR AT SUTHERLIN.

NOTE: For Possible Further Information On This Station, Please Contact The Douglas
County Surveyors Office, Rm. 205 Douglas County Justice Bldg., Roseburg, OR.
97470 Phone 672-3311 Ext. 272. Douglas County residents outside the
Roseburg calling area dial toll free 1-800-452-0991.