



OFFICE OF THE
DOUGLAS COUNTY SURVEYOR

V-009

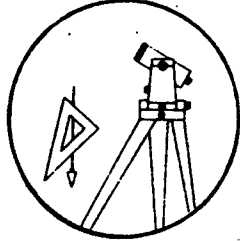

V-009

Station: V 499 T 30 S, R 4W, Sec 9
 Set By (Agency): USC&GS
 Date Set: 1949
 Recovered By JP-RS
 Date Recovered 3-15-82
 Recovered By _____
 Date Recovered _____
 Recovered By _____
 Date Recovered _____

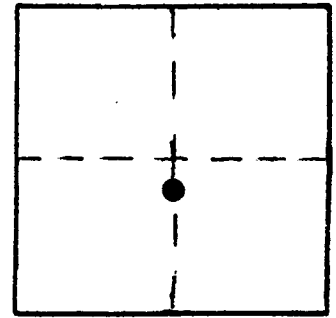

VERTICAL CONTROL CORPSCOM6 NAVD88 761.799 FT.

Elevation: 758.427 NGS Line # 130 USGS Line # _____ OSHD Line # _____
 Precision: 2nd Agency: USC&GS Proj. # _____ Date: 1957

HORIZONTAL CONTROL

South Zone State Plane Coordinates: Y(Northing) 488335 X(Easting) 4209425
 Precision: GIS SCALED Agency: DCSO Proj. # _____ Date: 2014


Approximate Geographic Position: Latitude _____ Longitude _____

DESCRIPTION and TO REACH

Found: A standard USC&GS disk set in concrete post stamped "V 499 1949". Station is 0.2 ft. above ground level and 2.0 ft. lower than edge of the pavement. Witness sign and post lie 1 ft. South.

To Reach: From the intersection of Hwy. 227 and Co. Rd. 94 in S.9 T30S, R4W, proceed Westerly along Hwy 227 0.35 mi. to station on the right.

SKETCH

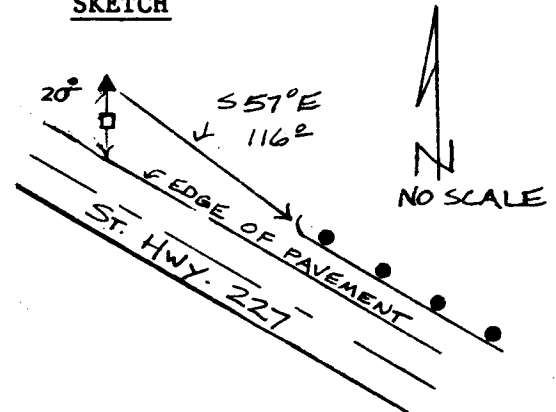

Reference Marks:

Note: For further information, contact the Douglas County Surveyor's Office, Room 205 Douglas County Justice Building, Roseburg, OR 97470. Phone 440-4278. Douglas County residents outside the Roseburg calling area, dial toll free 1-800-452-0991.