

OFFICE OF THE
DOUGLAS COUNTY SURVEYOR

Station: V 615 T 31 S, R 5W , Sec 13

Set By (Agency): OSHD

Date Set: 1966

Recovered By RWS, SJF


Date Recovered _____

Recovered By _____


Date Recovered _____

Recovered By _____

Date Recovered _____

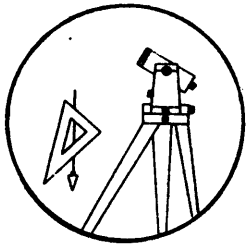

V-016

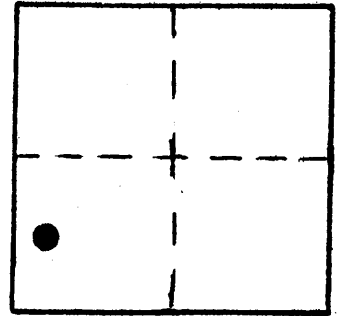

VERTICAL CONTROL NGVD 29

Elevation: 1134.59 NGS Line # _____ USGS Line # _____ OSHD Line # 369

Precision: 3rd Agency: OSHD Proj. # _____ Date: 1980

HORIZONTAL CONTROL

South Zone State Plane Coordinates: Y(Northing) _____ X(Easting) _____

Precision: _____ Agency: _____ Proj. # _____ Date: _____

Approximate Geographic Position: Latitude _____ Longitude _____

DESCRIPTION and TO REACH


SKETCH

DESCRIPTION:

An OSHD disk stamped "V 615 1968" set in a 6 inch diameter concrete post, protruding 5 inches above ground.

TO REACH:

From the Richie Rd. overcrossing of I-5 (exit 95) in T31S, R5W, Sec. 2, proceed southerly along I-5 approx. 2.6 miles to monument on right.

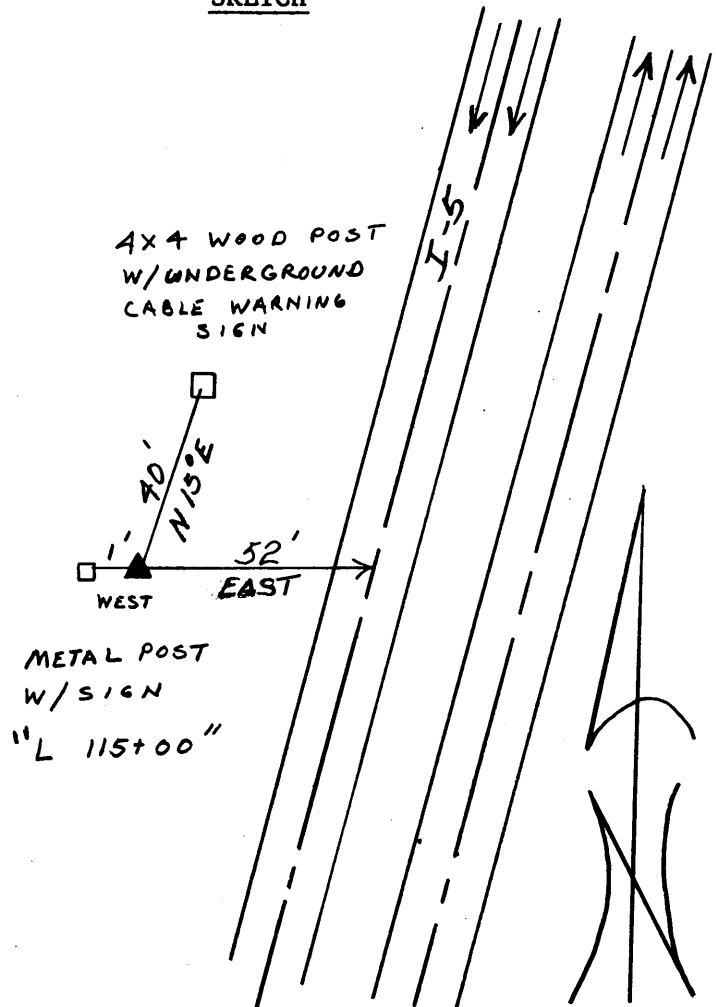

Reference Marks:

Note: For further information, contact the Douglas County Surveyor's Office, Room 205 Douglas County Justice Building, Roseburg, OR 97470. Phone 440-4278. Douglas County residents outside the Roseburg calling area, dial toll free 1-800-452-0991.