


V-036

OFFICE OF THE DOUGLAS COUNTY SURVEYOR


Station: VETCH
Date Set: 1999
Set By (Agency): DCSO
Date Recovered: 7-6-99
Recovered By: RWS/SIF

T 27 S, R 2, Sec 9

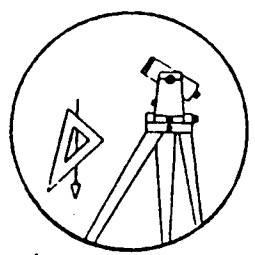

V-036

- Found
- New
- Reset
- Not Found
- Referenced
- Destroyed

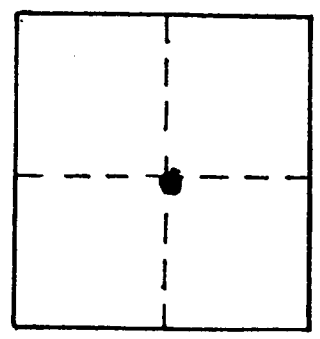

VERTICAL CONTROL

Elevation: 1083.40 NGS Line # _____ USGS Line # _____ OSHD Line # _____
Precision: 3rd Agency: DCSO Proj. # 2007 Date: 1999

HORIZONTAL CONTROL CORPSCONG NAVD88 1087.08 FT. CS66156

South Zone O.C.S. 27: Y(Northing) _____ X(Easting) _____
South Zone O.C.S. 83: Y(Northing) 581319 X(Easting) 4270711
Precision: G15 SCALED Agency: DCSO Proj. # _____ Date: 2014
Approx. ^{DCS 27} ~~NAD 83~~ Geographic Position: Latitude 43°14'09" Longitude 122°56'26"

DESCRIPTION and TO REACH

DCSO BRASS CAP SET IN LARGE ROCK
STAMPED " VETCH 1999 " 4 FT BELOW ROAD
FROM THE INTERSECTION OF LITTLE RIVER
ROAD (CORP MC) AND ENTRANCE TO WOLF
CRBEK JOB CORP. IN T 27 S R 2 W SEC 9
PROCEED SOUTH EASTERLY ALONG LITTLE RIVER
ROAD 0.4 MILES TO MONUMENT ON RIGHT.

Reference Marks:

