


DOUGLAS COUNTY SURVEYOR

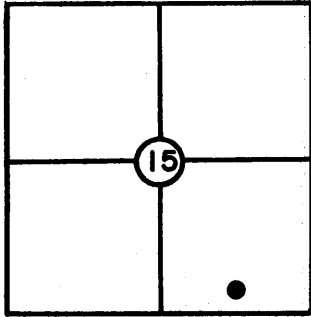

T 22 S, R 8W, Sec. 15
 Station: W 246
 Set By (Agency): Ore. Geod. Survey
 Date: 1934

NGVD 29

VERTICAL CONTROL

Elevation: 121.328 NGS(USC&GS) Line # 16 USGS Line # _____

Order Of Precision 1st Agency: USC&GS Proj. #: _____ Date: 1947

HORIZONTAL CONTROL


Oregon State Plane Coordinates: Y(Northing) _____ X(Easting) _____
(South Zone)

Order Of Precision _____ Agency: _____ Proj. #: _____ Date: _____

Approximate Geographic Position: Latitude= _____ Longitude= _____

DESCRIPTION: Standard brass cap set in
concrete post on Hwy. 38. 50ft. N. of
centerline and on a 4ft. cut bank. No other
landmarks. Station is over run with scotch
broom.

SKETCH

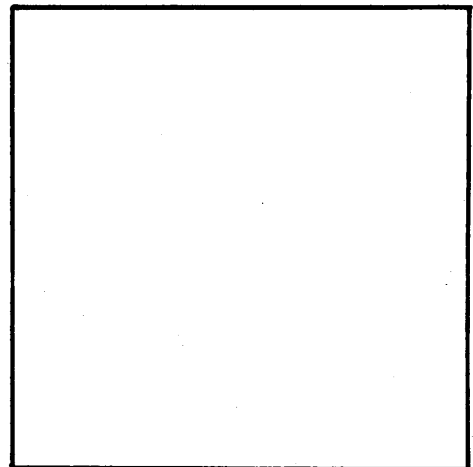

VICINITY: Approx. 3.7 mi. Northwest of
Elkton on Hwy. 38.

NOTE: For Possible Further Information On This Station, Please Contact The Douglas County Surveyors Office, Rm. 205 Douglas County Justice Bldg., Roseburg, OR. 97470 Phone 672-3311 Ext. 272.. Douglas County residents outside the Roseburg calling area dial toll free 1-800-452-0991.



1. 14. 2009