

OFFICE OF THE
DOUGLAS COUNTY SURVEYOR

Station: W 738

T21S R4W Sec. 11

Date Set: 1987

Set By (Agency): NGS

DCSO Designation: W-056

Date Recovered: 7-93



Recovered By: SJF

Date Recovered: _____

Recovered By: _____

Date Recovered: _____

Recovered By: _____

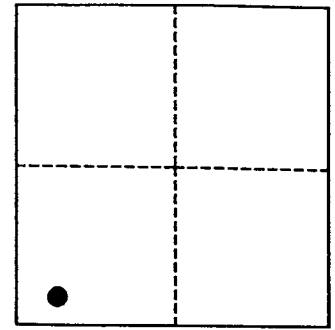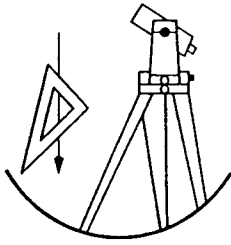

VERTICAL CONTROL

~~NGVD 29~~ ^{NAVD 88} Elevation: 634.787 FEET NAVD 88 Elevation: 193.483 METERS

NGS Line # 125035 USGS LINE # _____ OSHD Line # _____ FILE # _____

Precision: 1ST ORDER Agency: NGS Proj: _____ Date: 1988

HORIZONTAL CONTROL

O.C.S. 27 Y(Northing): _____ O.C.S. 83 Y(Northing): 770921

(South Zone) X(Easting): _____ (South Zone) X(Easting): 4222629

Precision: GKS SCALED Agency: DCSO Proj: _____ Date: 2014

Approx. O.C.S. 27 Geographic Position: Latitude: 43°45'06" Longitude: 123°08'36"

Approx. O.C.S. 83 Geographic Position: Latitude: _____ Longitude: _____

Found: A 3- 5/8 inch diameter NGS disk stamped "W 738 1987 set vertically and flush approx. 4.5 feet above ground level in the first pier northwest of the southeast abutment of the I-5 overcrossing of Wards Butte Rd. (BLM Rd. #21-4-11.1)

To reach: From the undercrossing of Bear Creek Rd. (Co. Rd. #62) and I-5, i.e. exit 163, (T21S R4W Sec19) proceed northerly along I-5 approx, 4.3 miles to mile point 167.65 and monument on right.

