

OFFICE OF THE
DOUGLAS COUNTY SURVEYOR

Station: WALTER


T 23 S, R 4W, Sec 10

Date Set: 1997


Set By (Agency): DCSO

Date Recovered: 2-12-97

Recovered By: RWS SIF

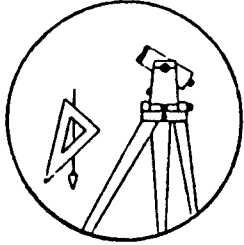

- Found
- Reset
- Referenced
- New
- Not Found
- Destroyed

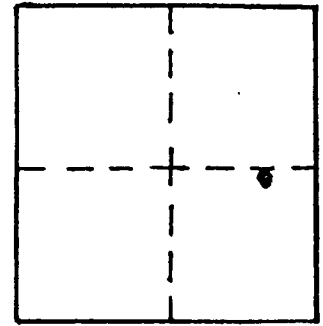

VERTICAL CONTROL

Elevation: 826.01 NGS Line # _____ USGS Line # _____ OSHD Line # _____

Precision: 3rd Agency: DCSO Proj. # 2007 Date: 1997

HORIZONTAL CONTROL CORPSCON6 NAVD88 829.71 FT. CS 66/54

South Zone O.C.S. 27: Y(Northing) _____ X(Easting) _____

South Zone O.C.S. 83: Y(Northing) 709795 X(Easting) 4219205

Precision: GIS SCALED Agency: DCSO Proj. # _____ Date: 2014

Approx. 1927 Geographic Position: Latitude 43°35'02" Longitude 123°08'56"

DESCRIPTION and TO REACH

DCSO DRILL CAP SET IN SOUTHWEST END OF
CONCRETE BRIDGE CURB OVER A SMALL CREEK
STAMPED "WALTER 1997".

FROM THE INTERSECTION OF CO. RD #8 (SCOTT'S
VALLEY RD) AND CO. RD #8A (LONDON RD) (ALTRIS R4L)
SEC 3 PROCEED SOUTHERLY ALONG SCOTT'S VALLEY RD
1/4 MILES TO MONUMENT ON LEFT IN SOUTHWEST CORNER
OF BRIDGE

Reference Marks:

