


**DOUGLAS COUNTY SURVEYOR'S OFFICE**

Designation: W-073 Station: WINDY T 22S R 13W S 12 1/4 NE

Date Set: 1995 Set by (Agency): ODOT

Date Recovered: 5/11/06 Recovered by: SJF, JAP

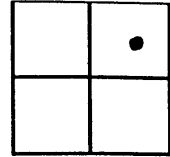

- Found
- New
- Reset
- Not Found
- Referenced
- Destroyed

VERTICAL CONTROL

NGVD 29 Elevation: 13.46 Feet File # CS 67/19  
 Precision: 3rd Agency: DCSO Project: \_\_\_\_\_ Date: 2006  
 NAVD 88 Elevation: \_\_\_\_\_ Meters File # \_\_\_\_\_  
 Precision: \_\_\_\_\_ Agency: \_\_\_\_\_ Project: \_\_\_\_\_ Date: \_\_\_\_\_

HORIZONTAL CONTROL - south zone

N 754504.36 E 3946327.65 Datum/Adj.: NAD83 Precision: GIS  
 Lat: 43:40:40.92 Long: 124:11:11.42 Agency: LS# 52989 PRIVATE File # CS67/19 Date: 2006  
 N \_\_\_\_\_ E \_\_\_\_\_ Datum/Adj.: \_\_\_\_\_ Precision: \_\_\_\_\_  
 Lat: \_\_\_\_\_ Long: \_\_\_\_\_ Agency: \_\_\_\_\_ File # \_\_\_\_\_ Date: \_\_\_\_\_  
DESCRIPTION AND TO REACH

AN O.D.O.T. GEODETIC CONTROL BRASS  
RISK STAMPED "WINDY 1995" SET  
FLUSH IN TOP OF A 0<sup>95</sup> X 0<sup>95</sup> FOOT  
SQUARE CONCRETE PAD SET SLIGHT-  
LY LOWER THAN TOP SURFACE OF A  
RIP-RAP SEA WALL.

FROM THE WINCHESTER CREEK  
BRIDGE OF SALMON HARBOR DRIVE  
(Co. Rd. #251) IN T22S, R12W, SEC. 7)  
PROCEED WESTERLY ALONG SALMON HAR-  
BOR DRIVE APPROX. 0.40 MILES TO THE  
WEST SHORE OF THE SALMON HARBOR  
WEST SPIT; THEN PROCEED NORTH  
ALONG A BIKE PATH APPROX. 900 FT TO  
MONUMENT ON LEFT.

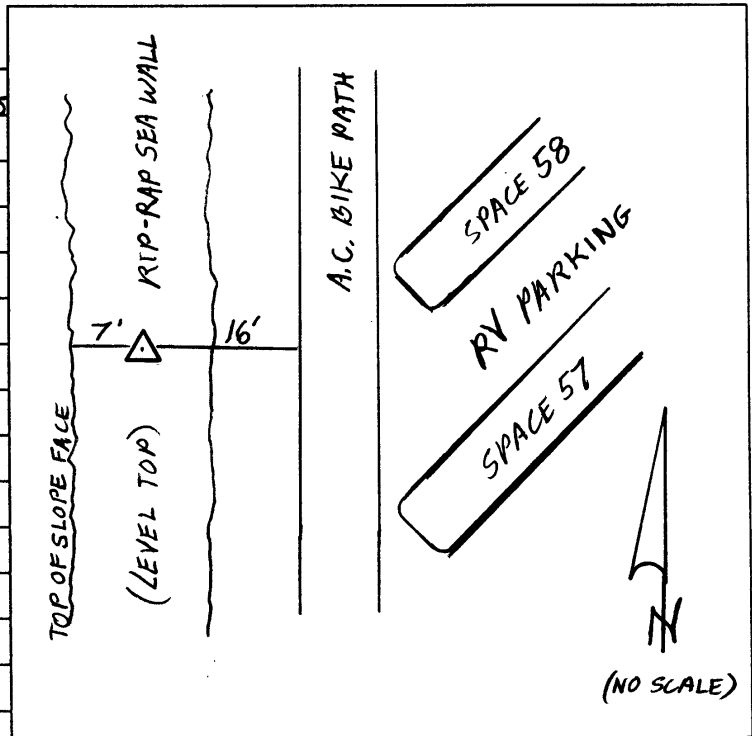


PHOTO FILE NAME

LOCATION

# 100-1295 (3/12/08 renamed W-073)

PROCESSED BY: \_\_\_\_\_

DATE: \_\_\_\_\_



9.20.2006