
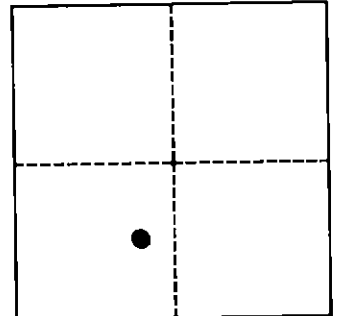


OFFICE OF THE  
DOUGLAS COUNTY SURVEYOR

Station: X-9  
 Date Set: 1920  
 Set By (Agency): USC&GS  
 DCSD Designation: X-001  
 Date Recovered: 6-22-84  
 Recovered By: \_\_\_\_\_  
 Date Recovered: \_\_\_\_\_  
 Recovered By: \_\_\_\_\_  
 Date Recovered: \_\_\_\_\_  
 Recovered By: \_\_\_\_\_

T28W R6W Sec. 11

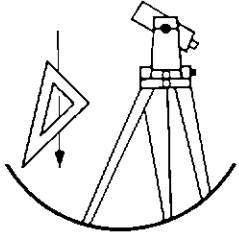

VERTICAL CONTROL


NGVD 29 Elevation: 512.282 FEET      NAVD 88 Elevation: 157.205 METERS  
 NGS Line # 6      USGS LINE # \_\_\_\_\_      OSHD Line # \_\_\_\_\_      FILE # \_\_\_\_\_  
 Precision: 1ST ORDER      Agency: USC&GS      Proj: \_\_\_\_\_      Date: 1957

HORIZONTAL CONTROL

O.C.S. 27    Y(Northing): \_\_\_\_\_      O.C.S. 83    Y(Northing): \_\_\_\_\_  
 (South Zone)    X(Easting): \_\_\_\_\_      (South Zone)    X(Easting): \_\_\_\_\_  
 Precision: \_\_\_\_\_      Agency: \_\_\_\_\_      Proj: \_\_\_\_\_      Date: \_\_\_\_\_  
 Approx. O.C.S. 27 Geographic Position:    Latitude: 43°08'45"    Longitude: 123°22'29"  
 Approx. O.C.S. 83 Geographic Position:    Latitude: \_\_\_\_\_    Longitude: \_\_\_\_\_

Description:    A USC&GS disk stamped "ELEV. 511.662 FT X-9 1920" set in the northeast corner of a Southern Pacific Railway concrete bridge curb (Roberts Creek crossing).

To reach:    From the intersection of State Hwy 99 and Winery Lane in T28S R6W Sec11 proceed southerly along Winery Lane approx. 0.2 miles to a sharp left hand corner. Monument lies 50 feet on the right.

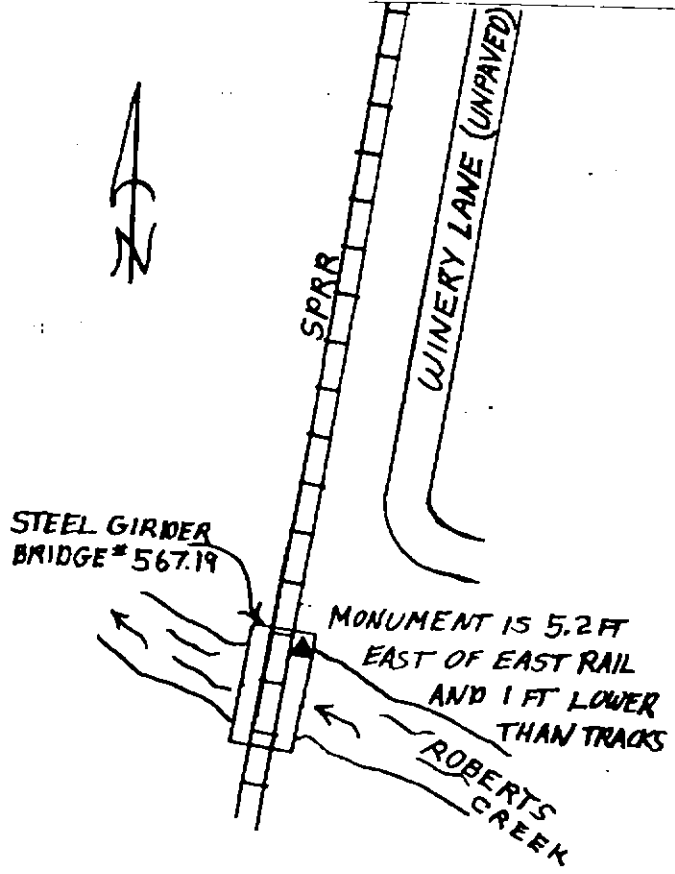

Note: For further information contact the Douglas County Surveyors Office, Room 205 Douglas County Justice Building, Roseburg, OR 97470. Phone 440-4272. Douglas County Residents outside Roseburg calling area, dial toll free 1-800-477-0991.