


OFFICE OF THE

DOUGLAS COUNTY SURVEYOR

X-003
X 246

20

NAD 83 736408.40 1162443.43
Elev 146.010

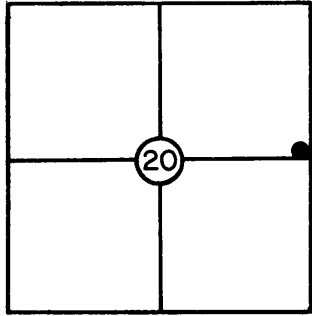

X-003

VERTICAL CONTROL

T 22 S, R 8W, Sec. 20

Station: X 246

Set By (Agency): Ore. Geod. Sur.

Date: 1934

NGVD 29

Elevation: 146.010 NGS(USC&GS) Line # 16 USGS Line # _____

Order

Of Precision 3rd Agency: O.G.S. Proj. #: _____ Date: 1934

HORIZONTAL CONTROL

NAD 27

Oregon State Plane Coordinates: Y(Northing) 736,437.25 X(Easting) 1,162,443.43
(South Zone)


Order

Of Precision 1/10,000 Agency: DCSO Proj. #: 2006 Date: 1972

Approximate Geographic Position: Latitude= _____ Longitude= _____

DESCRIPTION: About 1,300ft. N. of a long
horseshoe curve, about 700ft. N.E. of a barn
West of the highway, about 400ft. E. of a small
house with two maple trees in front, about 150
ft. E of the Hwy., about 100ft. E. of an old
Rd. 75ft. E. of a fence, on the bare West slope
and in the top of a 3x5ft. boulder. A state
survey standard disk, stamped "146 X 246 1934"

SKETCH

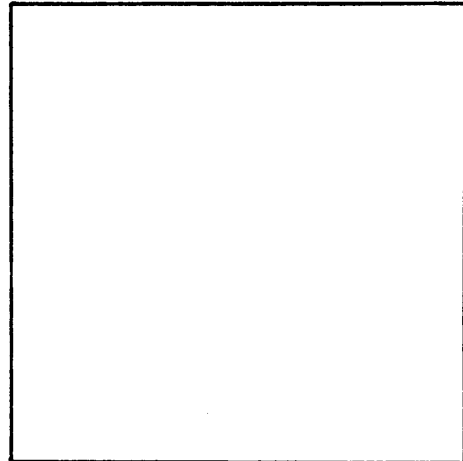

VICINITY: Approx. 6.1 mi. N.W. of Elkton.
on Umpqua Highway.

NOTE: For Possible Further Information On This Station, Please Contact The Douglas County Surveyors Office, Rm. 205 Douglas County Justice Bldg., Roseburg, OR. 97470 Phone 672-3311 Ext. 272.. Douglas County residents outside the Roseburg calling area dial toll free 1-800-452-0991.