


OFFICE OF THE
DOUGLAS COUNTY SURVEYOR

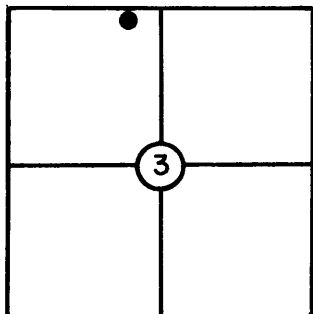

X-008

T 22 S, R 12W, Sec. 3

Station: X 457

Set By (Agency): OSHD

Date: 1954

VERTICAL CONTROL NGVD 29

Elevation: 34.245 NGS(USC&GS) Line # 73 USGS Line # _____

Order
Of Precision 3rd Agency: OSHD Proj. #: _____ Date: 1947

HORIZONTAL CONTROL

Oregon State Plane Coordinates: Y(Northing) _____ X(Easting) _____
(South Zone)

Order
Of Precision _____ Agency: _____ Proj. #: _____ Date: _____


Approximate Geographic Position: Latitude= _____ Longitude= _____

DESCRIPTION: Sta. is located at the S. end
and downstream side of the Schofield Cr. Bridge,
and set in the sidewalk. Also 32 ft. right
of Engineer Sta. 3+50.

Note" This B.M. replaces "D 56"
0.9mi. S. along the Hwy. 101 from Reedsport.

VICINITY: Reedsport

SKETCH

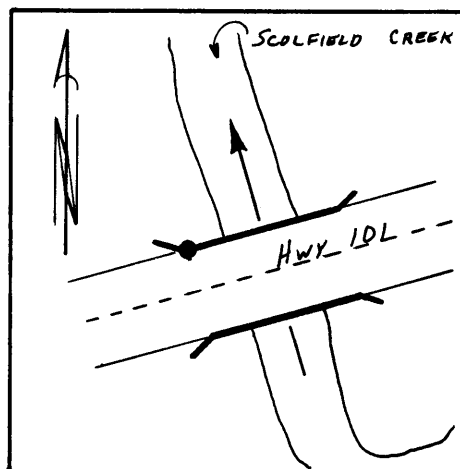

NOTE: For Possible Further Information On This Station, Please Contact The Douglas County Surveyors Office, Rm. 205 Douglas County Justice Bldg., Roseburg, OR. 97470 Phone 672-3311 Ext. 272.. Douglas County residents outside the Roseburg calling area dial toll free 1-800-452-0991.