

OFFICE OF THE
DOUGLAS COUNTY SURVEYOR

Station: X-610 T 29 S, R 6W , Sec 1

Set By (Agency): OSHD

Date Set: 1967

Recovered By TP-JP


Date Recovered 4-28-82

Recovered By _____


Date Recovered _____

Recovered By _____

Date Recovered _____

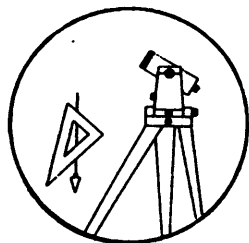

X-014

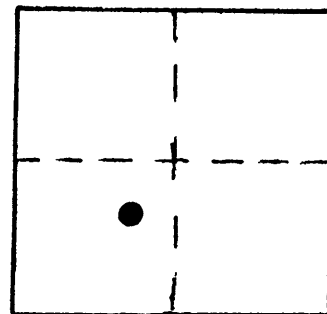

VERTICAL CONTROL NGVD 29

Elevation: 634.46 NGS Line # _____ USGS Line # _____ OSHD Line # 369

Precision: 3rd Agency: OSHD Proj. # _____ Date: 1957

HORIZONTAL CONTROL

South Zone State Plane Coordinates: Y(Northing) _____ X(Easting) _____

Precision: _____ Agency: _____ Proj. # _____ Date: _____

Approximate Geographic Position: Latitude _____ Longitude _____

DESCRIPTION and TO REACH

SKETCH

Found: A standard OSHD disk stamped "X-610 1967" set in the N.E. corner of the South bound lane of I-5 overcrossing of Clarks Branch Rd. at Clarks Branch interchange, in curb 0.5 ft. above roadway.

To reach: At the intersection of Clarks Branch Rd. and South Bound I-5 (in sec. 1 T29S R6W).

Reference Marks:

Note: For further information, contact the Douglas County Surveyor's Office, Room 205 Douglas County Justice Building, Roseburg, OR 97470. Phone 440-4278. Douglas County residents outside the Roseburg calling area, dial toll free 1-800-452-0991.