

OFFICE OF THE
DOUGLAS COUNTY SURVEYOR

Station: X-021

T 26 S, R 3W , Sec 1

Date Set: 1991

Set By (Agency): DCSO

Date Recovered: 8-9-91


Recovered By: RWS, SJF 1997

Date Recovered: _____

Recovered By: _____

Date Recovered: _____

Recovered By: _____

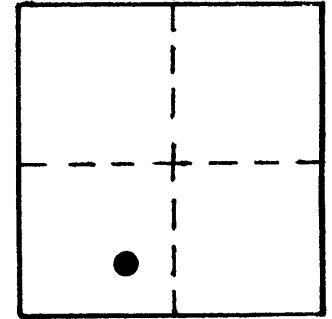

X-021
X-021

NAD 617377.67 4255330.50
83 43°20' 0" 123° 0'12"

VERTICAL CONTROL NGVD 29

Elevation: ~~792.4~~ 792.45 NGS Line # _____ USGS Line # _____ OSHD Line # _____

Precision: ~~GPS~~ 3rd Agency: DCSO Proj. # 2008 Date: ~~1991~~ 1997

HORIZONTAL CONTROL

South Zone O.C.S. 27: Y(Northing) 617,413.18 X(Easting) 1,334,370.48

South Zone O.C.S. 83: Y(Northing) _____ X(Easting) _____

Precision: 1/25,000 Agency: DCSO Proj. # GPS 27/83 Date: 1991


Approx. NAD ~~83~~ Geographic Position: Latitude 43° 20' 0.7 Longitude 123° 00' 08.1"

DESCRIPTION and TO REACH

SKETCH

Set: A DCSO disk stamped "X-021 1991" set in concrete apron at west end of bridge.

To Reach: From the intersection of North Umpqua Hwy., (St. Hwy 138) and Swift Water Rd. (USFS Rd. #26-3-1.1) in T26S, R3W, sec. 1 proceed easterly along St. Hwy. 138 approx. 500 ft. to bridge over Rock Creek, Mon. is near northwest cor. of bridge.

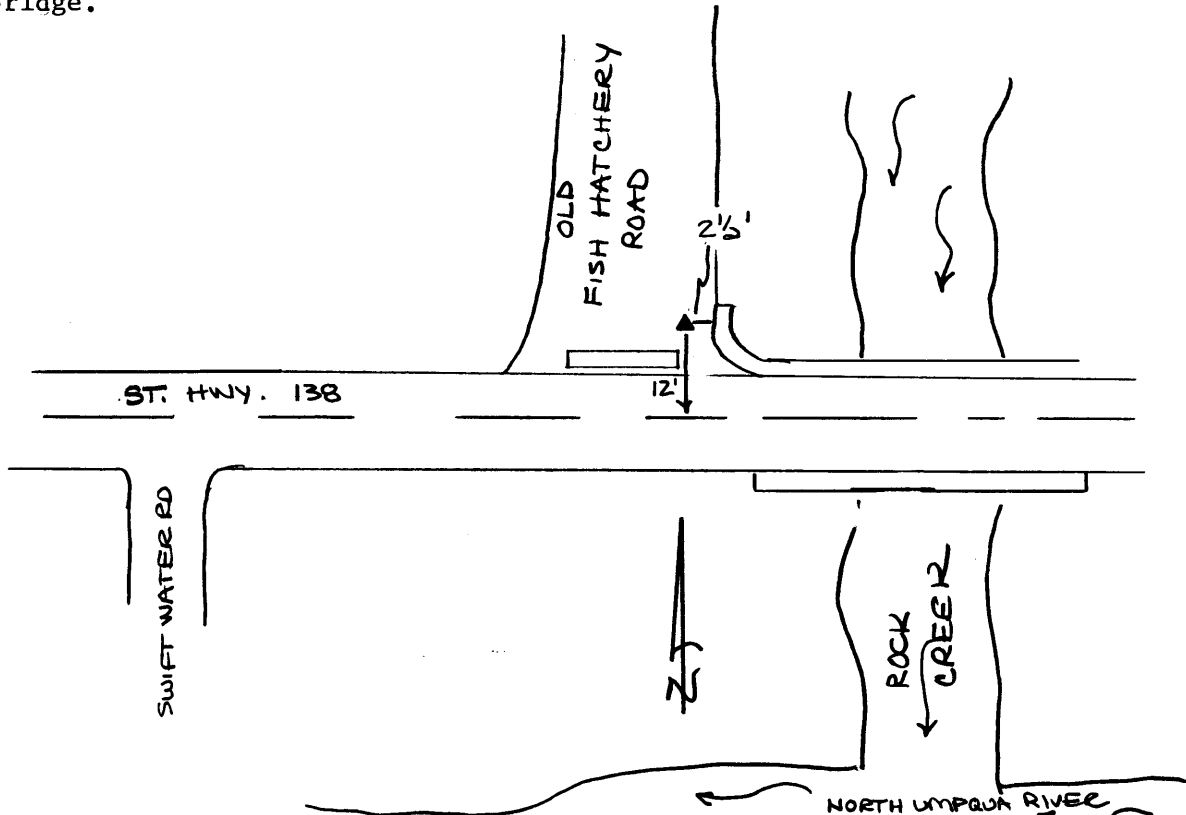

Reference Marks:

Note: For further information, contact the Douglas County Surveyor's Office, Room 205 Douglas County Justice Building, Roseburg, OR 97470. Phone 440-4278. Douglas County residents outside the Roseburg calling area, dial toll free 1-800-452-0991.