



OFFICE OF THE
DOUGLAS COUNTY SURVEYOR

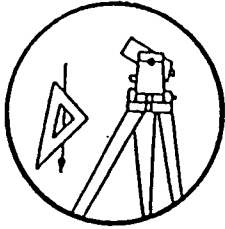

Station: X-048
Date Set: 1992
Set By (Agency): DCSO
DCSO Designation: X-048
Date Recovered: 7/16/92
Recovered By: TF HS
Date Recovered: _____
Recovered By: _____
Date Recovered: _____
Recovered By: _____

T 29 S, R 4 W, Sec 29

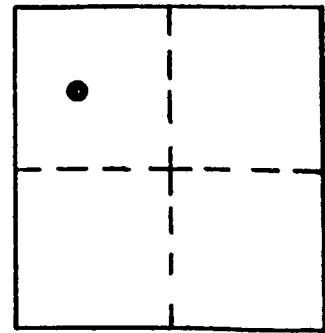

VERTICAL CONTROL CORPSCON6 NAVDB8 762.346 FT.

Elevation: 758.956 NGS Line # _____ USGS Line # _____ OSHD Line # _____

Precision: 2ND ORDER Agency: DCSO Proj. # 2007 Date: 1992

C566147

HORIZONTAL CONTROL

O.C.S. 27 Y(Northing): _____ O.C.S. 83 Y(Northing): 506134


South Zone X(Easting): _____ South Zone X(Easting): 4198242

Precision: ^{GIS} SCALED Agency: DCSO Proj. # _____ Date: 2014

^{Scaled} 27 ~~Approx.~~ NAD 83 Geographic Position: Latitude 43°01'25" Longitude 123°12'12"

Set: A standard DCSO disk stamped "X-048 1992"
set in a 6" x 36" corrugated sewer pipe protruding
3" from the ground and filled with concrete.

To reach: From the intersection of South Myrtle
Rd. (Co.Rd.#18) and Riverside Dr. (Co.Rd.#18A) in
T29S R5W sec. 23, continue on South Myrtle Rd. to MP
4.15 and mon. on the right.

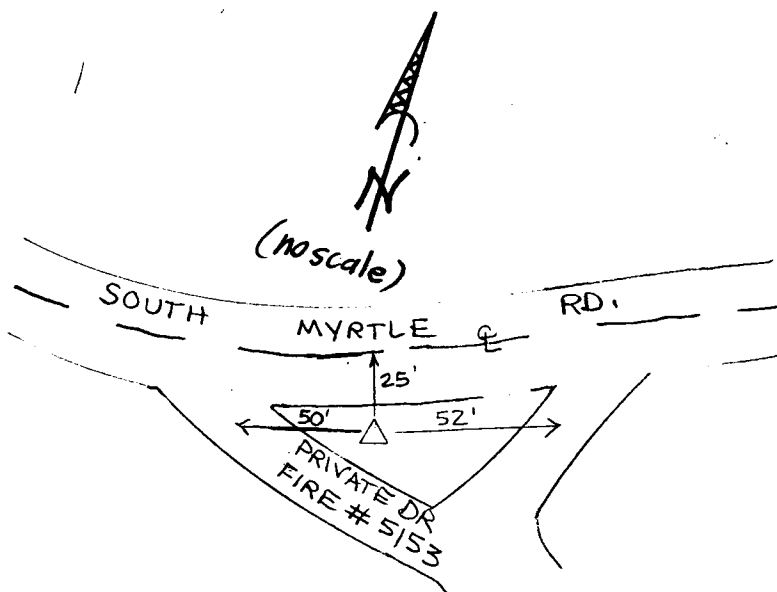

Note: For possible further information contact the Douglas County Surveyors Office,
Room 205 Douglas County Justice Building, Roseburg, OR 97470. Phone 440-4272.
Douglas County residents outside the Roseburg calling area, dial toll free
1-800-477-0991.