


Z-009

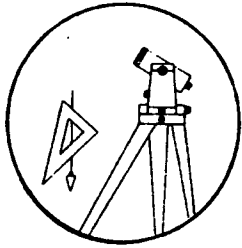

Set By (Agency): USC&GS

Date Set: 1954

Recovered By PB,RS


Date Recovered 11/7/83

Recovered By _____

Date Recovered _____

Recovered By _____

Date Recovered _____

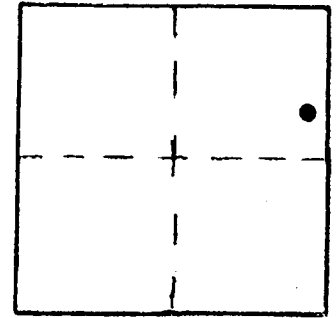

VERTICAL CONTROL

Elevation: 592.299 NGS Line # 6 USGS Line # _____ OSHD Line # 369, 1977

Precision: 1st Agency: USC&GS Proj. # _____ Date: 1957

HORIZONTAL CONTROL CORPSCON6 NAVD88 595.735 FT.

South Zone State Plane Coordinates: Y(Northing) 511408 X(Easting) 4166482

Precision: GIS SCALED Agency: DCSO Proj. # _____ Date: 2014

Approximate Geographic Position: Latitude _____ Longitude _____

DESCRIPTION and TO REACH

SKETCH

DESCRIPTION:


A disk stamped "Z 552 1954" set flush on a concrete railroad headwall.

TO REACH:

From the intersection of Main St. (Old Hwy.99) and Dole Rd. (Co. Rd. #14) in T29S,R5W,Sec.28 in Myrtle Creek; proceed northwesterly 2.0 miles along Dole Rd. to monument on right.

~~4166482.49~~

~~511408.85~~

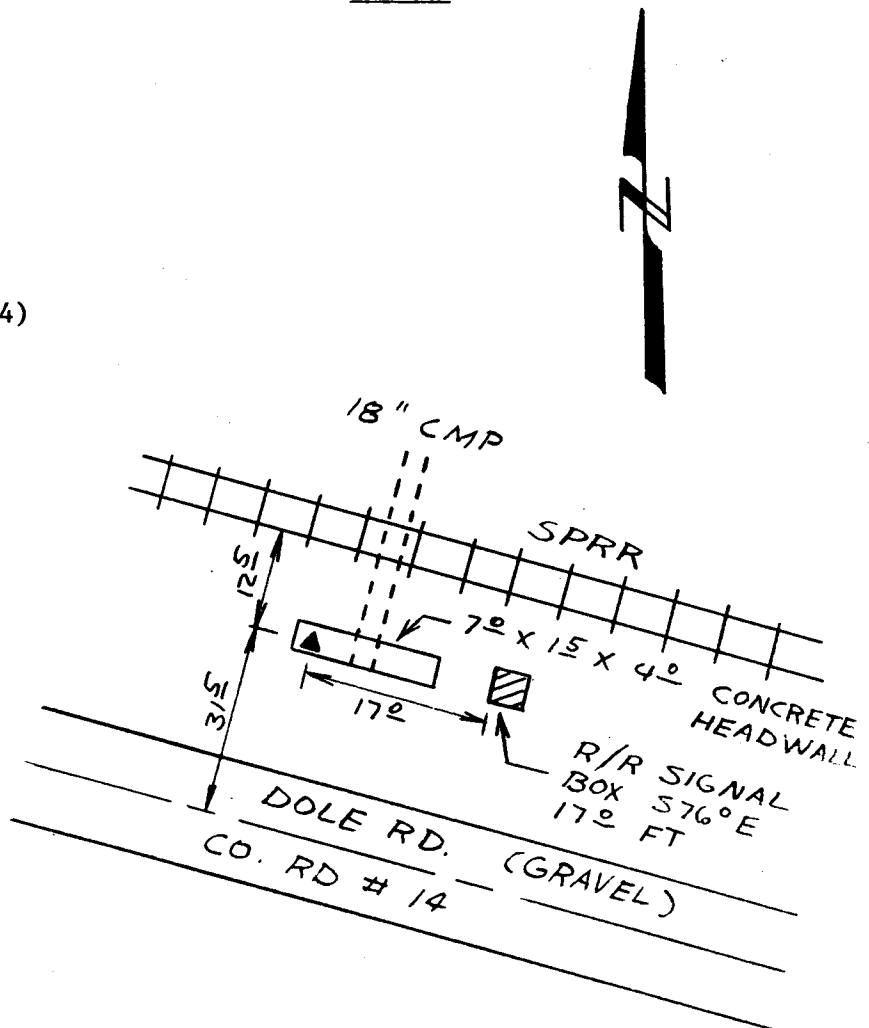

Reference Marks:

Note: For further information, contact the Douglas County Surveyor's Office, Room 205 Douglas County Justice Building, Roseburg, OR 97470. Phone 440-4278. Douglas County residents outside the Roseburg calling area, dial toll free 1-800-452-0991.