

OFFICE OF THE
DOUGLAS COUNTY SURVEYOR

Station: S-18 T 20 S, R 10W , Sec 32
Set By (Agency): DCSO
Date Set: 1973
Recovered By GQ - TP
Date Recovered 1-28-82
Recovered By _____
Date Recovered _____
Recovered By _____
Date Recovered _____

S-021
S-18
20S 10W 32

NAD 790798.24 4017970.98
83 43°47' 9" 123°55'17"

NGVD 29
VERTICAL CONTROL

Elevation: 231.726 NGS Line # _____ USGS Line # _____ OSHD Line # _____
Precision: 2nd Agency: DCSO Proj. # 2006 Date: 1973

HORIZONTAL CONTROL NAD 27

South Zone State Plane Coordinates: Y(Northing) 790,833.85 X(Easting) 1,097,010.62
Precision: 1/25,000 Agency: DCSO Proj. # 2006 Date: 1973
Approximate Geographic Position: Latitude 43°47'10" Longitude 123°55'13"


DESCRIPTION and TO REACH

Found: Standard DCSO disk set in concrete tile stamped "S-18 1973". Survey marker sign alongside.

To reach: From the intersection of Co. Rd. 48A & Rd. #48 (in sec 31 T20S R10W) proceed northeasterly along Rd. #48 0.8 miles to monument on the right.

SKETCH

Reference Marks:

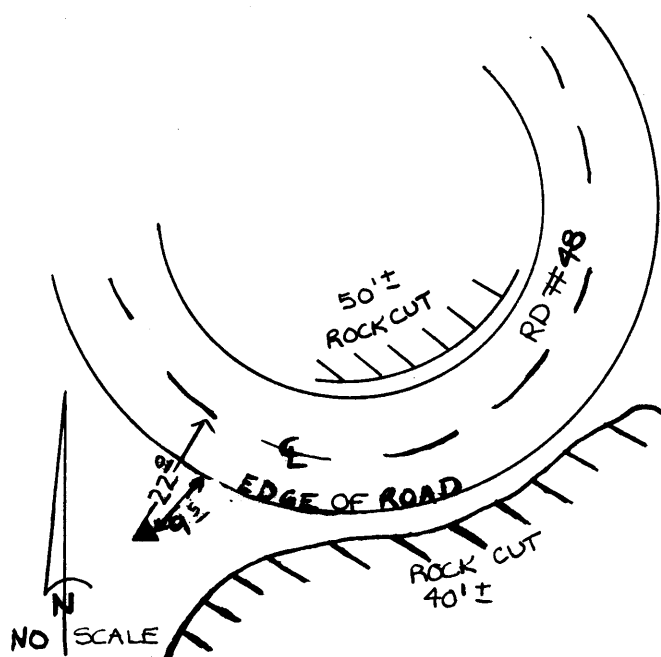

Note: For further information, contact the Douglas County Surveyor's Office, Room 205 Douglas County Justice Building, Roseburg, OR 97470. Phone 440-4278. Douglas County residents outside the Roseburg calling area, dial toll free 1-800-452-0991.