

OFFICE OF THE
DOUGLAS COUNTY SURVEYOR

Station: ADRIENNE

T 21 S, R 4W, Sec 30

Set By (Agency): DCSO

Date Set: 1978

Recovered By GO


Date Recovered 4/83

Recovered By _____

Date Recovered _____

Recovered By _____

Date Recovered _____

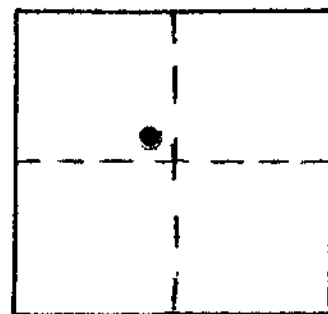

a-031 21S 4W 30

ADRIENNE

NAD 758124.10 4202050.86

83 43°42'53" 123°13'15"

VERTICAL CONTROL

Elevation: _____ NGS Line # _____ USGS Line # _____ OSHD Line # _____

Precision: _____ Agency: _____ Proj. # _____ Date: _____

HORIZONTAL CONTROL

South Zone State Plane Coordinates: Y(Northing) 758,158.75 X(Easting) 1,281,089.92

Precision: 1/50,000 Agency: DCSO Proj. # 2008 Date: 1979

Approximate Geographic Position: Latitude 43°42'54" Longitude 123°13'11"

DESCRIPTION and TO REACH


SKETCH

DESCRIPTION:

Station mark is a standard DCSO disk stamped "ADRIENNE 1978" set in a concrete filled belltile 8 inches below ground.

TO REACH:

From the southerly intersection of Hwy. 99 and State route 200 (road to Lorane) proceed southerly on Hwy. 99 100 ft. to monument on left. All in T21S, R4W, Sec.30.

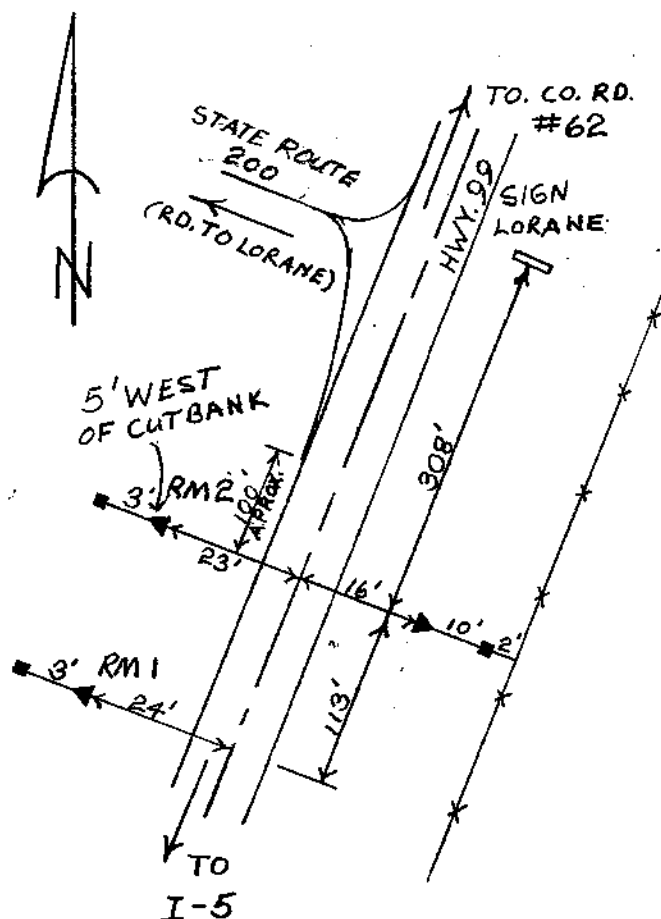

Reference Marks:

A brass cap set in concrete tile stamped "ADRIENNE RM1 1978" bears S 63°39' 25" W 119.22 ft. (grid)

A brass cap set in concrete tile stamped "ADRIENNE RM2 1978" bears N 44°34' 29" W 43.76 ft. (grid)

Note: For further information, contact the Douglas County Surveyor's Office, Room 205 Douglas County Justice Building, Roseburg, OR 97470. Phone 440-4278. Douglas County residents outside the Roseburg calling area, dial toll free 1-800-452-0991.