

OFFICE OF THE  
DOUGLAS COUNTY SURVEYOR

Station: DELORIS RESET T 21 S, R 5 W, Sec 35

Set By (Agency): DCSO

Date Set: 1989

Recovered By RWS,SJF


Date Recovered \_\_\_\_\_

Recovered By \_\_\_\_\_

Date Recovered \_\_\_\_\_

Recovered By \_\_\_\_\_

Date Recovered \_\_\_\_\_

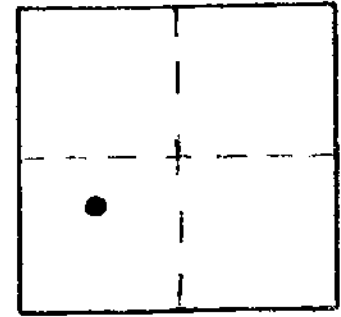

D-071 21S 5W 35  
DELORIS RESET

NAD 752739.03 4190162.74  
83 43°41'58" 123°15'54"

VERTICAL CONTROL

Elevation: \_\_\_\_\_ NGS Line # \_\_\_\_\_ USGS Line # \_\_\_\_\_ OSHD Line # \_\_\_\_\_

Precision: \_\_\_\_\_ Agency: \_\_\_\_\_ Proj. # \_\_\_\_\_ Date: \_\_\_\_\_

HORIZONTAL CONTROL

South Zone State Plane Coordinates: Y(Northing) 752,973.86 X(Easting) 1,269,201.90

Precision: 1/25,000 Agency: DCSO Proj. # 2008 Date: 1989

Approximate Geographic Position: Latitude 43°41'59" Longitude 123°15'50"


DESCRIPTION and TO REACH

A DCSO disk stamped "DELORIS RESET 1989"  
set in an 8 in. o.d. by 42 in. long concrete  
filled belltile protruding 4 in. above ground.

TO REACH:

From the intersection of Hwy. 99 and I-5 access  
road to Hwy. 99 (south of Curtin) in T21S,R4W,  
Sec. 30, proceed westerly along Hwy.99 approx.  
2.3 miles to monument on left.

SKETCH

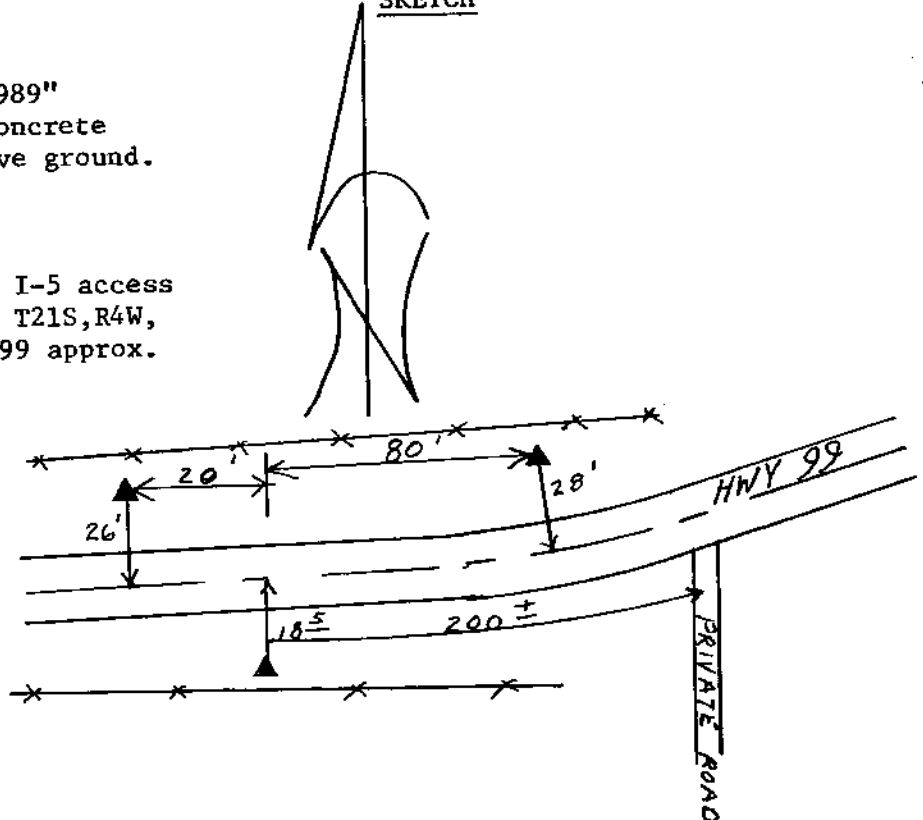

Reference Marks:

A DCSO disk stamped "DELORIS RM1 1978"  
bears N 43°17'14" E, 101.58 ft. (grid).

A DCSO disk stamped "DELORIS RM2 1978"  
bears N 27°32'33" W, 59.32 ft. (grid).

Note: For further information, contact the Douglas County Surveyor's Office, Room 205  
Douglas County Justice Building, Roseburg, OR 97470. Phone 440-4278. Douglas  
County residents outside the Roseburg calling area, dial toll free 1-800-452-0991.