

PLS 500500

OFFICE OF THE
DOUGLAS COUNTY SURVEYOR

Station: SE Cor.

T 21 S, R 7W , Sec 10

Date Set: 1955

Set By (Agency): PLS #239

Date Recovered: 4-8-92



Recovered By: RWS, SJF, JP

Date Recovered: _____

Recovered By: _____

Date Recovered: _____

Recovered By: _____

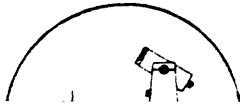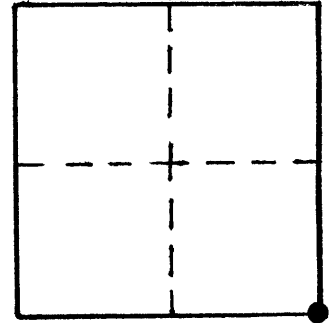

210-07W-10-030 21S 07W 10
SE CORNER

NAD 773081.86 4126957.70
83 43°44'56" 123°30'24"

VERTICAL CONTROL

Elevation: 1264.4 NGS Line # _____ USGS Line # _____ OSHD Line # _____

Precision: GPS Agency: DCSO Proj. # 2015 Date: 1992

HORIZONTAL CONTROL

South Zone O.C.S. 27: Y(Northing) 773,116.78 X(Easting) 1,205,997.36

South Zone O.C.S. 83: Y(Northing) _____ X(Easting) _____

Precision: 1:5000 Agency: DCSO Proj. # 2015 Date: 1992

Approx. NAD ~~83~~₂₇ Geographic Position: Latitude 43°44'56" Longitude 123°30'20"

DESCRIPTION and TO REACH

SKETCH

FOR INFORMATION SEE DOUGLAS COUNTY SURVEYORS OFFICE RECORDS OF GOVERNMENT CORNERS RENEWED.

SEE GIS COMP. FILES

Reference Marks:

Note: For further information, contact the Douglas County Surveyor's Office, Room 205 Douglas County Justice Building, Roseburg, OR 97470. Phone 440-4278. Douglas County residents outside the Roseburg calling area, dial toll free 1-800-452-0991.