

OFFICE OF THE  
DOUGLAS COUNTY SURVEYOR

Station: S-20 T 21 S, R 10W , Sec 5

Set By (Agency): DCSO

Date Set: 1973

Recovered By LEM


Date Recovered 1-82

Recovered By \_\_\_\_\_

Date Recovered \_\_\_\_\_

Recovered By \_\_\_\_\_

Date Recovered \_\_\_\_\_

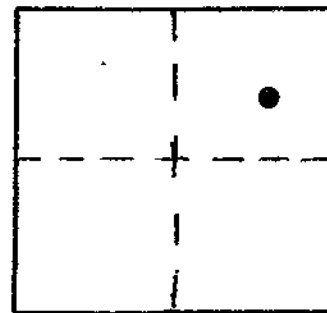

S-023 21S 10W 5  
S-20

NAD 788096.73 4020414.77  
83 43°46'43" 123°54'43"

VERTICAL CONTROL

Elevation: 57.177 NGS Line # \_\_\_\_\_ USGS Line # \_\_\_\_\_ OSHD Line # \_\_\_\_\_

Precision: 2nd Agency: DCSO Proj. # 2006 Date: 1973

HORIZONTAL CONTROL

South Zone State Plane Coordinates: Y(Northing) 788,132.36 X(Easting) 1,099,454.34

Precision: 1/25,000 Agency: DCSO Proj. # 2006 Date: 1973


Approximate Geographic Position: Latitude 43°46'44" Longitude 123°54'38"

DESCRIPTION and TO REACH

SKETCH

Found: A standard DCSO disk set flush with the ground in a boulder. Monument is approx. 1½ ft. lower than asphalt level and 6 ½ ft. West of Westerly pavement edge.

To reach: From the intersection of Co.Rd. #48 (North Fork Smith River) and Smith River Rd. in T20S R10W sec. 31. Proceed easterly along Smith River Rd. 2.0 miles to monument on the right.

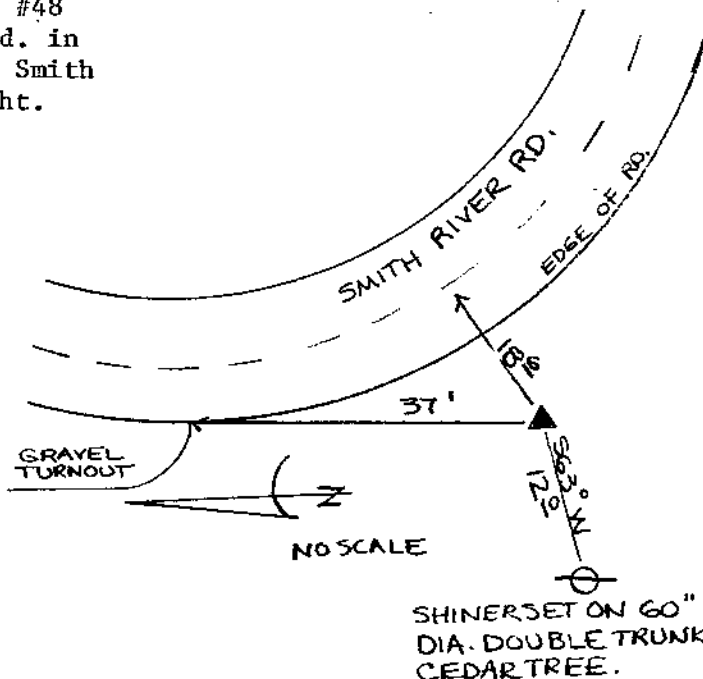

Reference Marks:

Note: For further information, contact the Douglas County Surveyor's Office, Room 205 Douglas County Justice Building, Roseburg, OR 97470. Phone 440-4278. Douglas County residents outside the Roseburg calling area, dial toll free 1-800-452-0991.