

2/82


OFFICE OF THE

t-039
TIMBER

22S 5W 9

DOUGLAS COUNTY SURVEYOR

NAD	745653.85	4180309.81
83	43°40'43"	123°18' 5"

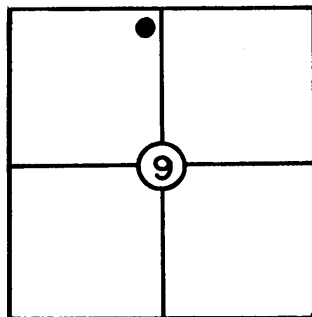

T-039

VERTICAL CONTROLT 22 S, R 5W, Sec. 9Station: TIMBERSet By (Agency): DCSODate: 1979

Elevation: _____ NGS(USC&GS) Line # _____ USGS Line # _____

 Order
 Of Precision _____ Agency: _____ Proj. #: _____ Date: _____
HORIZONTAL CONTROL

NAD 27

 Oregon State Plane Coordinates: Y(Northing) 745,688.68 X(Easting) 1,259,349.13
 (South Zone)

(North County)


 Order
 Of Precision 1/25,000 Agency: DCSO Proj. #: 2008 Date: 1979
Approximate Geographic Position: Latitude= 43° 40' 44" Longitude= 123° 18' 01"

DESCRIPTION: A standard DCSO brass cap set in
conc. and iron filled bell tile 6"x39" buried
35" in the ground, 36.5 ft., S 60° E, to ctr.
of SPRR, 9 ft., N 28° E, to edge of pavement
of Co. Rd. #68, survey marker on RR crossing
sign 23 ft.

A DCSO disk stamped "TIMBER RM 1 1979", set
 flush with ground bears N 7° 54' 34" W 81.54' (grid)
 A DCSO disk stamped "TIMBER RM 2 1979", set 5"
 below surface bears S 77° 25' 38" E 142.36' (grid)

VICINITY: 1.25 miles northerly from Drain onHwy. 99 to Co. Rd. #68 (Laurel Hill Dr.)

SKETCH

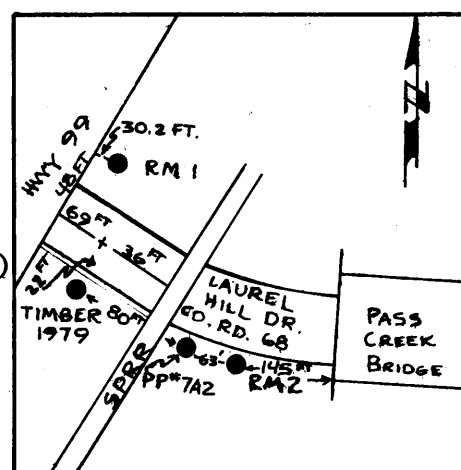

NOTE: For Possible Further Information On This Station, Please Contact The Douglas
 County Surveyors Office, Rm. 205 Douglas County Justice Bldg., Roseburg, OR.
 97470 Phone 672-3311 Ext. 272.. Douglas County residents outside the
 Roseburg calling area dial toll free 1-800-452-0991.