

OFFICE OF THE  
DOUGLAS COUNTY SURVEYOR




J-016  
JAMEY

22S 5W 28

NAD 726606.68 4182111.70  
83 43°37'36" 123°17'32"

Station: Jamey  
Date Set: 1979  
Set By (Agency): DCSO  
Date Recovered: 9/87  
Recovered By: RWS, SJF  
Date Recovered: 7/91  
Recovered By: TF  
Date Recovered:  
Recovered By:

T 22 S, R 5W, Sec 28

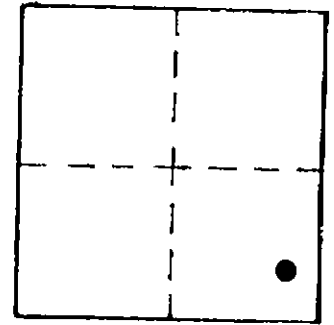

VERTICAL CONTROL

Elevation: 332.9 NGS Line # USGS Line # OSHD Line #  
Precision: GPS Agency: DCSO Proj. # 2008 Date: 1991

HORIZONTAL CONTROL


South Zone O.C.S. 27: Y(Northing) 726,641.47 X(Easting) 1,261,151.26  
South Zone O.C.S. 83: Y(Northing) X(Easting)  
Precision: 1/15,000 Agency: DCSO Proj. # 2008 Date: 1979  
Approx. NAD 83 Geographic Position: Latitude Longitude

DESCRIPTION and TO REACH

SKETCH

A standard DCSO brass cap set in a 2 1/2'x 4' concrete semaphore.

To Reach: From the intersection of Main St. and St. Hwy. 99 in Yoncalla (T23S, R5W, sec. 3), proceed northerly approx. 1.8 mi. to mon on right. Mon. lies just north and across rd. from Box 384.

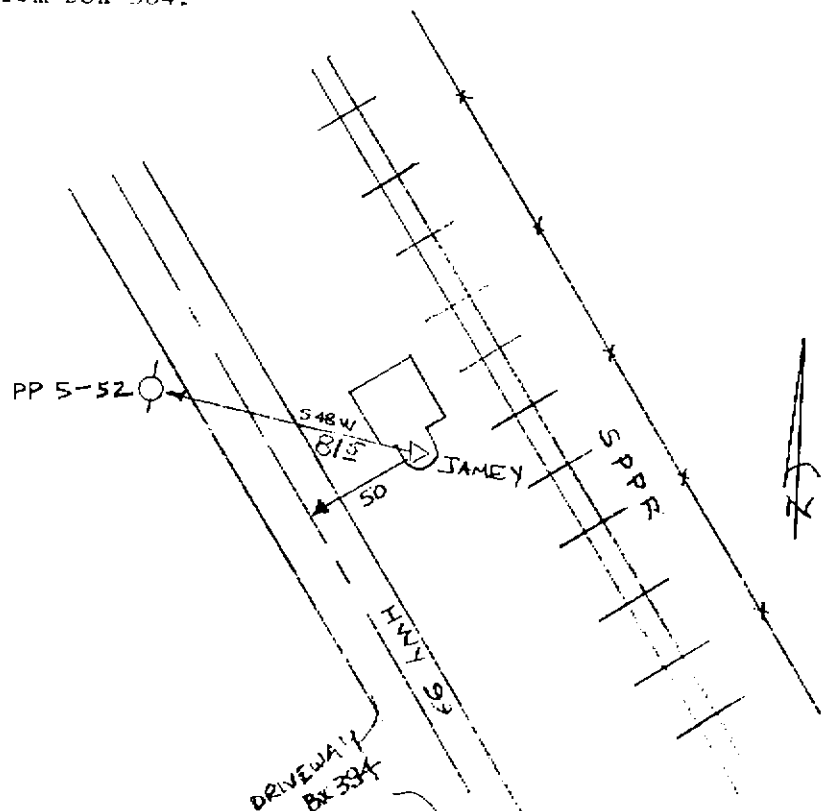

Reference Marks:

Note: For further information, contact the Douglas County Surveyor's Office, Room 205 Douglas County Justice Building, Roseburg, OR 97470. Phone 440-4278. Douglas County residents outside the Roseburg calling area, dial toll free 1-800-452-0991.