

Douglas County Geodetic Data Sheet


Station: COLLEEN

Designation: C-098

T 22 R 06 S 11

Date Set: 1981 Set By (Agency): DCSO

Last Date Recovered:

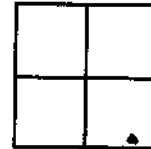

VERTICAL CONTROL

NGVD 29 Elevation: Feet

Precision: Agency:

Project:

Date:

NAVD 88 Elevation: Meters

Precision: Agency:

Project:

Date:

NGS Line # USGS Line #

OSHD Line #

File #

HORIZONTAL CONTROL

OCS 27 Y(Northing): 741,625.44 X(Easting): 1,240,633.94 Lat Long:

Precision: 1/25,000 Agency: DCSO Project: 2004-21 Date: 1981

OCS 83 Y(Northing): 741,590.66 X(Easting): 4,161,594.40 Lat: 43°39'57" Long: 123°22'18"

Precision: Agency: Project: Date:

OCS 83/91 Y(Northing): X(Easting): Lat: Long:

Precision: Agency: Project: Date:

OCS 27 Scaled Latitude: 43°39'57" OCS 27 Scaled Longitude: 123°22'13"


DESCRIPTION:

STATION IS A DCSO BRASS CAP SET IN A 6X42 INCH CONCRETE BELLTILE; STAMPED COLLEEN 1981. STATION IS APPROX 3 INCHES ABOVE THE GROUND

COMMENTS:

STATION LIES APPROX 425 FT SOUTHWESTERLY OF THE INTERSECTION OF CO RD 65; HARDSCRABBLE RD AND STATE HWY 38. WITNESS POST IS APPROX 3 FT NORTH OF STATION. STATION IS APPROX 27 FT NORTH OF CENTERLINE OF STATE HWY 38. VICINITY - NORTHWESTERLY OF DRAIN OREGON

SKETCH

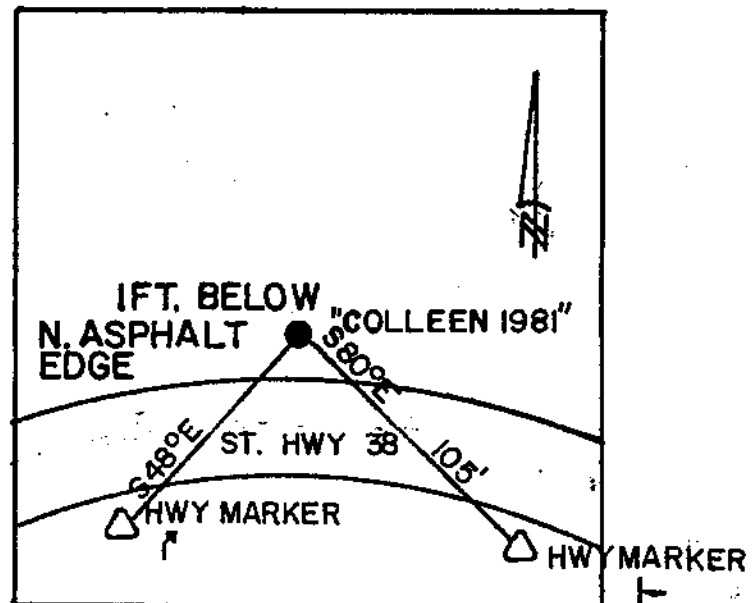

Note: For further information contact the Douglas County Surveyors Office, Room 105A Douglas County Courthouse, Roseburg, OR 97470. Phone 440-4272 or Fax (541)957-8150. Douglas County Residents outside Roseburg calling area, dial toll free 1-800-224-1619.