


OFFICE OF THE

DOUGLAS COUNTY SURVEYOR

u-066
U-65

225 8W 16

NAD 741051.76 4084377.98
83 43°39'24" 123°39'47"

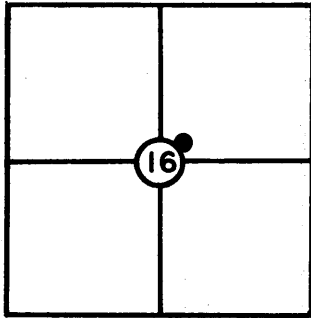

U-066

VERTICAL CONTROL

T 22 S, R 8W, Sec. 16

Station: U 65

Set By (Agency): DCSO

Date: 1972

Elevation: _____ NGS(USC&GS) Line # _____ USGS Line # _____

Order
Of Precision _____ Agency: _____ Proj. #: _____ Date: _____

HORIZONTAL CONTROL

NAD 27

Oregon State Plane Coordinates: Y(Northing) 741,086.61 X(Easting) 1,163,417.68
(South Zone)

Order
Of Precision 1/10,000 Agency: DCSO Proj. #: 2006 Date: 1972


Approximate Geographic Position: Latitude= _____ Longitude= _____

DESCRIPTION: From junction of Mehl Creek
and Henderer Cr. Rd. go W'stly on Henderer Cr.
Rd. Approx. 7.3mi.

Bronze disk set in concrete post, Survey
marker alongside stamped "U-65 1972"
1.0ft. higher than rd.

VICINITY: Henderer Rd.

SKETCH

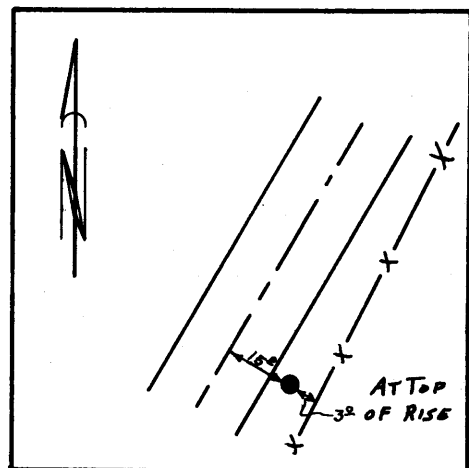

NOTE: For Possible Further Information On This Station, Please Contact The Douglas County Surveyors Office, Rm. 205 Douglas County Justice Bldg., Roseburg, OR. 97470 Phone 672-3311 Ext. 272.. Douglas County residents outside the Roseburg calling area dial toll free 1-800-452-0991.