



Station: HEN-7
Date Set: 1998
Set By (Agency): DCSO
Date Recovered: 7-28-98
Recovered By: RWS SJF

T 22 S, R 8W, Sec 29

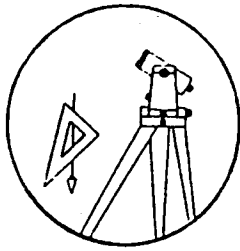

H-076

- Found
- New
- Reset
- Not Found
- Referenced
- Destroyed

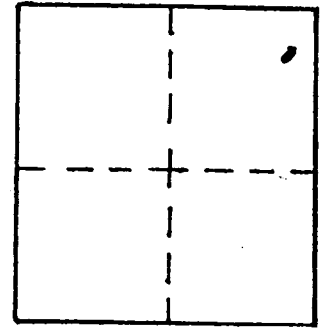

VERTICAL CONTROL

Elevation: 91.18 NGS Line # _____ USGS Line # _____ OSHD Line # _____

Precision: 3rd Agency: DCSO Proj. # 2007 Date: 1998

HORIZONTAL CONTROL CORPSCON6 NAVD88 94.75 FT. CS66152

South Zone O.C.S. 27: Y(Northing) _____ X(Easting) _____

South Zone O.C.S. 83: Y(Northing) 732077 X(Easting) 4083075

Precision: GIS SCALED Agency: DCSO Proj. # _____ Date: 2014

Approx. NAD 83 Geographic Position: Latitude 43° 37' 56" Longitude 123° 39' 56"

DESCRIPTION and TO REACH

2 3/4" DIA DCSO DRILL CAP STAMPED "HEN-7 1998"
IS SET IN THE "SOUTH EAST" ABUTMENT OF
A CONCRETE BRIDGE OVER A SMALL CREEK

FROM THE INTERSECTION OF MILL CREEK RD
(CO. RD #11) AND HENDERER ROAD (CO. RD #118)
IN T22S R8W SEC 30, PROCEED NORTHWESTERLY
ALONG HENDERER ROAD 5.40 TO HENDERER ROAD
(CO. RD #67A AND BRIDGE ROAD (22-8-29.1))
PROCEED WESTERLY ALONG HENDERER ROAD 500 FT
TO CONCRETE BRIDGE AND MONUMENT ON LEFT.

Reference Marks:

