


OFFICE OF THE
DOUGLAS COUNTY SURVEYOR


Station: PTS 101-14
Set By (Agency): DCSO
Date Set: 1975
Recovered By GQ - TP
Date Recovered 2-2-82
Recovered By _____
Date Recovered _____
Recovered By _____
Date Recovered _____

T 22 S, R 12W , Sec 5

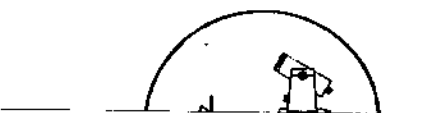

p-093 22S 12W 5
PTS-101-14

NAD 755872.33 3956149.99
83 43°40'59" 124° 8'59"

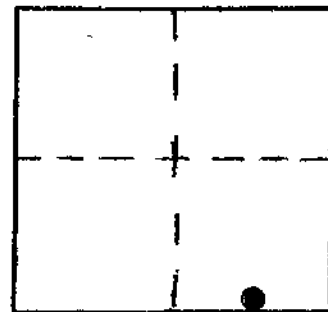

VERTICAL CONTROL

Elevation: _____ NGS Line # _____ USGS Line # _____ OSHD Line # _____
Precision: _____ Agency: _____ Proj. # _____ Date: _____

HORIZONTAL CONTROL


South Zone State Plane Coordinates: Y(Northing) 755,907.40 X(Easting) 1,035,189.31
Precision: 1/15,000 Agency: DCSO Proj. # 6004-16 Date: 1975
Approximate Geographic Position: Latitude 43°40'59" Longitude 124°08'54"

DESCRIPTION and TO REACH

SKETCH

Found: A standard DCSO disk set in concrete tile stamped "PTS 101-14 1975". Monument is set flush with the ground.

To reach: From the intersection of 22nd Ave. & Hwy. 101 in Reedsport, proceed Southerly 1.5 mi. to turn out on the right (portion of old Hwy.) proceed right, down turn out 0.1 mi. to monument on the left.

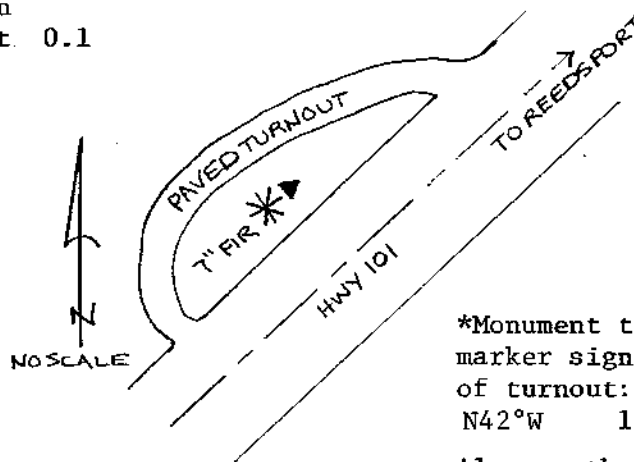

*Monument to survey marker sign on edge of turnout:

N42°W 16.0 ft.

Also another survey marker sign bears N 40° W, 2.5 ft.

Monument to 7" Fir bears S 70° W, 4.6 ft.

Monument to fog line Hwy 101 is 26 ft.

Reference Marks:

Monument to centerline of turnout road is 32 ft.

Note: For further information, contact the Douglas County Surveyor's Office, Room 205 Douglas County Justice Building, Roseburg, OR 97470. Phone 440-4278. Douglas County residents outside the Roseburg calling area, dial toll free 1-800-452-0991.