

4/82

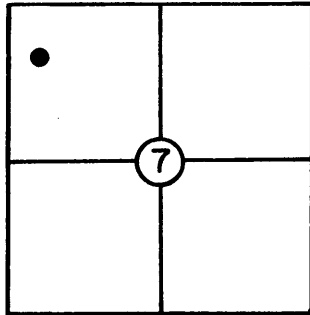
OFFICE OF THE

j-025
JOE

225 12W 7

DOUGLAS COUNTY SURVEYOR

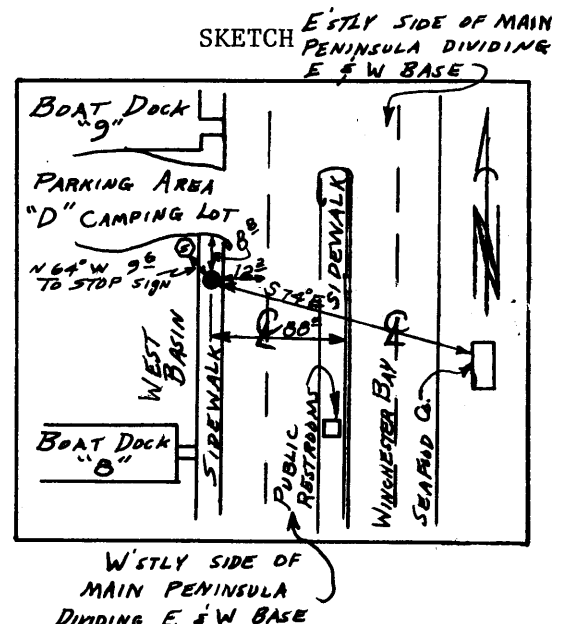
NAD	755372.31	3947845.25
83	43°40'50"	124°10'51"

T 22 S, R 12 W, Sec. 7Station: JOE EL. 12.426Set By (Agency): ?Date: ?VERTICAL CONTROL **NGVD 29**Elevation: 8.800 NGS(USC&GS) Line # USGS Line #

Order

Of Precision 2nd Agency: DCSO Proj. #: 2007 CS 61/16 Date: 1981HORIZONTAL CONTROL **NAD 27**Oregon State Plane Coordinates: Y(Northing) 755,407.31 X(Easting) 1,026,884.58
(South Zone)

Order

Of Precision 1/15,000 Agency: DCSO Proj. #: 2008 Date: 1980Approximate Geographic Position: Latitude= 43° 40' 51" Longitude= 124° 10' 47"DESCRIPTION: From intersection of 9th Blvd.and the W'stly side of Main Peninsula0.13 mi. to sta. on W. side of rd.,8.8 ft. S. of end of curb and driveway to"D" camping lot parking area. Station isa BC set in conc. sidewalk stamped "JOEEL. 12.426". See sketch.VICINITY: Salmon Harbor (Winchester Bay)

NOTE: For Possible Further Information On This Station, Please Contact The Douglas County Surveyors Office, Rm. 205 Douglas County Justice Bldg., Roseburg, OR. 97470 Phone 672-3311 Ext. 272. Douglas County residents outside the Roseburg calling area dial toll free 1-800-452-0991.