

OFFICE OF THE
DOUGLAS COUNTY SURVEYOR

Station: SE cor. S8 T 22 S, R 12 W, Sec 8

Set By (Agency): DCSO

300500

Date Set: 10/82

Recovered By GEQ



Date Recovered 4/83

Recovered By _____

Date Recovered _____

Recovered By _____

Date Recovered _____

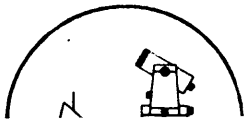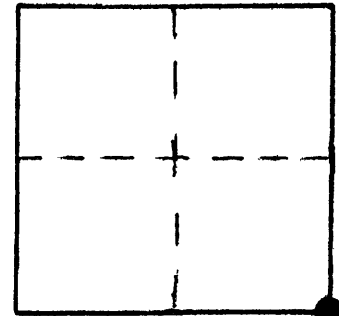

220-12W-08-018 22S 12W 08
SE CORNER

NAD 750463.83 3957257.15
83 43°40' 6" 124° 8' 40"

VERTICAL CONTROL

Elevation: _____ NGS Line # _____ USGS Line # _____ OSHD Line # _____

Precision: _____ Agency: _____ Proj. # _____ Date: _____

HORIZONTAL CONTROL NAD 27

South Zone State Plane Coordinates: Y(Northing) 750,497.90 X(Easting) 1,036,296.44

Precision: 1/5,000 Agency: DCSO Proj. # 6004-16 Date: 1983

Approximate Geographic Position: Latitude 43°40'06" Longitude 124°08'36"

DESCRIPTION and TO REACH

SKETCH

Monument is a 1"x30" iron pipe with a brass cap attached stamped "Douglas Co. Surveyor T22S S8 S9 S17 S16 R12W 1982". See Douglas Co. Surveyor records for renewed corners for more information.

COMPS. FOR CODED VALUES NOT FILLED
SEE FILES IN BACK OFFICE MARKED
22-12 CORNER TIES AND 22-12 SEC. 17

Reference Marks:

Note: For further information, contact the Douglas County Surveyor's Office, Room 205 Douglas County Justice Building, Roseburg, OR 97470. Phone 440-4278. Douglas County residents outside the Roseburg calling area, dial toll free 1-800-452-0991.